


Index  
 File No. G-11  
 T 5 S R. 34 E  
 Merid. Willamette

**CORNER RECORD (SEARCH)**

(Ref. FSM 7151.4)

R.D. LaGrande County Union Tract or Survey No. \_\_\_\_\_  
 N.F. WW-16 State Oregon Cor. No. C 1/4

**CORNER DIAGRAM**

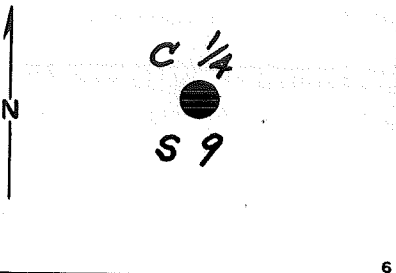

DESCRIBE CORNER MONUMENT FOUND 1

None

DESCRIBE BEARING TREES OR OTHER OFFICIAL ACCESSORIES FOUND 2

None

**PHOTO IDENTIFICATION DATA**

Photo No. \_\_\_\_\_  
 Filed At. \_\_\_\_\_  
 Object Ident. \_\_\_\_\_  
 Ident. By \_\_\_\_\_  
*Signature* 7

DESCRIBE CORNER LOCATION RELATIVE TO NEAR-BY FEATURES, ALSO HOW TO REACH CORNER 3

Approx. 1000 ft. S of road S536.

**PLANE COORDINATE POSITION DATA**

State \_\_\_\_\_ Zone \_\_\_\_\_  
 X \_\_\_\_\_  
 Y \_\_\_\_\_  
 Estab. By \_\_\_\_\_  
*Agency* 8

Signature Hambleton Title \_\_\_\_\_ Division ORLS Headquarters 645 Date 8-78 4  
 7100-52-(3/68) 5

**CORNER RECORD (PERPETUATION)**

MONUMENT: DESCRIBE NEW MONUMENT SET, OR WORK DONE TO PRESERVE EXISTING MONUMENT Set a 2 $\frac{1}{2}$ " x 30" iron pipe w/brass cap mkd.: Large mound of stone around monument.	T 5 S C 1/4 S 9 R 3/4 E 1978 ORLS 645
---	--

9

ACCESSORIES : DESCRIBE NEW BT'S WITNESS OBJECTS ETC. ESTABLISHED, OR WORK DONE TO PRESERVE EXISTING EVIDENCE

9" pine bears N 56 W, 58.46 ft. scribed  $\frac{1}{4}$ " S S 9 BT.  
 8" pine bears S 40 E, 36.11 ft. scribed  $\frac{1}{4}$ " S S 9 BT.  
 Painted blaze and band of BT's red & yellow. Tagged trees w/54-3&4 signs.  
 Set steel fence post by mound of stone w/signs 54-4,6&9.

10

Work Done By J. Hambleton Title Surveyor Date 8-78 State Registration No. ORLS 645  
 or Agency

Certified Cor. Record Prepared? Yes  No  Filed At: Union CS Date \_\_\_\_\_

11

REMARKS

Witnesses: L. Green  
 L. Shirley

12

Index File No.	T.	R.	M.	Tract or Surv. No.	Cor.
----------------	----	----	----	--------------------	------

13