


History of original corner establishment:

Corner established in 1882 by Rufus S. Moore under Contract No. 451.

60.00 chains set stone 12" x 12" x 10" for corner to Sections 12, 13, 7, 18.

A fir 13" diameter bears North 69° West 143 lks.

No record of subsequent remonumentation found in County Records.

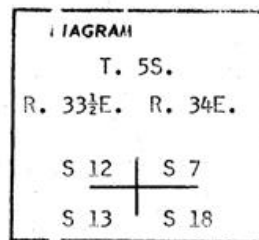

Description of corner evidence found:


None

Description of monument and accessories established to perpetuate the original location of this corner

Set 2 1/2" x 30" iron pipe 24" in ground with brass cap marked as shown: I scribed new Bearing Trees.

- A tamarack 8" diameter bears North 60°33' West 42.10 feet marked T. 5S., R. 33 1/2 E. S12BT
- A tamarack 14" diameter bears North 8°15' East 10.05 feet marked T. 5S., R. 34E. S 7 BT
- A tamarack 14" diameter bears South 34°50' East 30.60 feet marked T 5S. R 34E. S 18 BT
- A tamarack 10" diameter bears South 52°55' West 10.30 feet marked T. 5S. R. 33 1/2 E S 13 BT

I nailed brass washer marked PLS 933 to BT blaze of all trees. Set a steel post 3 feet East of corner. The corner is West 600 feet of North-South Road. Used T-2 and steel tape; measuring a horizontal distance to the center of Bearing Trees.

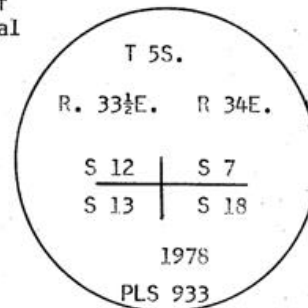

Office of.....County Surveyor..... County of.....Umatilla.....  
 State of.....Oregon....., I hereby certify that the within instrument was filed in this office:  
 for record on the..... day of.....  
 by.....  
 (COUNTY OFFICIAL) (DEPUTY)

J-25

Q-797