

CORNER RECORD (SEARCH)

Index File No. K-11

T 5S R. 34E

Merid. WM

R.D. LA GRANDE

N.F. W-W

Tract or Survey No. _____

County UMATILLA


State OREGON

Cor. No. 1/16

Center N 1/16 of

Sect. 16

CORNER DIAGRAM

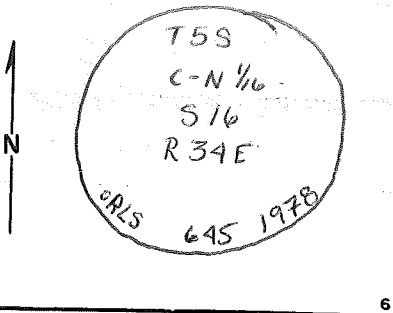

DESCRIBE CORNER MONUMENT FOUND 2 1/2" GALV. PIPE w/ 3" BRASS CAP

DESCRIBE BEARING TREES OR OTHER OFFICIAL ACCESSORIES FOUND 12" LODGE POLE PINE SCRIBES PLAINLY VISIBLE (DEAD) S35°W 74.2 FT

8" LODGE POLE PINE BLAZE PITCH SHUT (GOOD) N40°W 52.34 FT

PHOTO IDENTIFICATION DATA

Photo No. _____

Filed At. _____

Object Ident. _____

Ident. By _____

Signature _____

7

DESCRIBE CORNER LOCATION RELATIVE TO NEAR-BY FEATURES, ALSO HOW TO REACH CORNER

PLANE COORDINATE POSITION DATA

State _____ Zone _____

X _____

Y _____

Estab. By _____

Agency _____

8

Signature Tracy R. PATTERSON

Title CET

Division LLL

Headquarters GREZ

Date 6/16/93

7100-52-(3/68)

5

CORNER RECORD (PERPETUATION)

MONUMENT: DESCRIBE NEW MONUMENT SET, OR WORK DONE TO PRESERVE EXISTING MONUMENT

9

ACCESSORIES: DESCRIBE NEW BT'S WITNESS OBJECTS ETC. ESTABLISHED, OR WORK DONE TO PRESERVE EXISTING EVIDENCE

NEW MONUMENT SIGN ON NW B.T.
REPAINTED BLAZE & BANDS ON ALL B.T.'S

10

Work Done By _____ Title _____ Date _____ State Registration No. _____
or Agency _____

Certified Cor. Record Prepared? Yes No Filed At: _____ Date _____ 11

REMARKS

NEED TO SET NEW B.T. IN SW QUAD.

12

Index File No. K_T11 T. 5S R. 34E M. WM Tract or Surv. No. CN^{1/16} Cor. OF 13


SECT. 16

Index
 File No. K-11
 T 5 S R. 34 E-
 Merid. Willamette

CORNER RECORD (SEARCH)
 (Ref. FSM 7151.4)

R.D. LaGrande County Union State Oregon
 N.F. WW-16 Tract or Survey No. _____ Cor. No. N-C-1/16

CORNER DIAGRAM

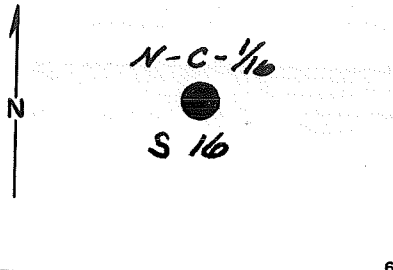

DESCRIBE CORNER MONUMENT FOUND 1

None

DESCRIBE BEARING TREES OR OTHER OFFICIAL ACCESSORIES FOUND 2

None

PHOTO IDENTIFICATION DATA 6

Photo No. _____
 Filed At. _____
 Object Ident. _____
 Ident. By _____
Signature _____ 7

DESCRIBE CORNER LOCATION RELATIVE TO NEAR-BY FEATURES, ALSO HOW TO REACH CORNER 3

Approx. 250 ft. W of Umapine Creek.

PLANE COORDINATE POSITION DATA 8

State _____ Zone _____
 X _____
 Y _____
 Estab. By _____
Agency _____

Signature
Hambleton

Title

Division
ORLS

Headquarters
645

Date
8-78

7100-52-(3/68)

CORNER RECORD (PERPETUATION)

MONUMENT: DESCRIBE NEW MONUMENT SET, OR WORK DONE TO PRESERVE EXISTING MONUMENT

Set a $2\frac{1}{2}$ " x 30" iron pipe w/brass cap mkd.:
 Large mound of stone around monument.

T 5 S
 N-C-1/16
 S 16
 R 34 E
 1978
 ORLS 645

ACCESSORIES : DESCRIBE NEW BT'S WITNESS OBJECTS ETC. ESTABLISHED, OR WORK DONE TO PRESERVE EXISTING EVIDENCE

5" pine bears N 40 W, 52.34 ft. scribed 1/16 S S 16 BT.
 7" pine bears S 35 W, 74.19 ft. scribed 1/16 S S 16 BT.
 Painted blaze and band of BT's red & yellow. Tagged trees w/54-3&4 signs.
 Set steel fence post by mound of stone w/signs 54-4,6&9.

Work Done By J. Hambleton Title Surveyor Date 8-78 State Registration No. ORLS 645
 or Agency

Certified Cor. Record Prepared? Yes No Filed At: Union CS Date _____ 11

REMARKS

Witnesses: L. Green
 L. Shirley