

Index

File No. Q-5

CORNER RECORD (SEARCH)

(Ref. FSM 7151.4)

Tract or Survey No. _____

Cor. No. 5 1/6

T 5S R. 35E

R.D. LA GRANDE

County UNION

OF SECT. 19E


Merid. WM

N.F. W-W

State OREGON

20

CORNER DIAGRAM

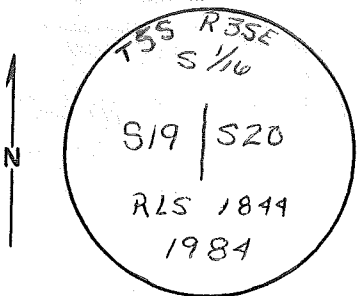

DESCRIBE CORNER MONUMENT FOUND 2 1/2" ALUMINUM CAP ON 2" PIPE 2" ABOVE GROUND

DESCRIBE BEARING TREES OR OTHER OFFICIAL ACCESSORIES FOUND

12" L.P. PINE S 32° W 29 FT. SCRIBES VISIBLE (S19)

12" L.P. PINE N 75 1/2° E 66 FT. SCRIBES VISIBLE (S20)

PHOTO IDENTIFICATION DATA

Photo No. _____

Filed At. _____

Object Ident. _____

Ident. By _____

Signature

PLANE COORDINATE POSITION DATA

State _____ Zone _____

X _____

Y _____

Estob. By _____

Agency

DESCRIBE CORNER LOCATION RELATIVE TO NEAR-BY FEATURES, ALSO HOW TO REACH CORNER

Signature

TRACY R. PATTERSON

Title

CET

Division

LLL

Headquarters

GREZ

Date

8/19/93

7100-52-(3/68)

CORNER RECORD (PERPETUATION)

MONUMENT: DESCRIBE NEW MONUMENT SET, OR WORK DONE TO PRESERVE EXISTING MONUMENT

ACCESSORIES : DESCRIBE NEW BT'S WITNESS OBJECTS ETC. ESTABLISHED, OR WORK DONE TO PRESERVE EXISTING EVIDENCE

ALL BT'S ARE IN GOOD SHAPE
REPAINTED ALL BANDS & BLAZES ON ALL B.T.'S

Work Done By _____ Title _____ Date _____ State Registration No. _____
or Agency _____

Certified Cor. Record Prepared ? Yes No Filed At: _____ Date _____

REMARKS

Index File No. Q-5 T. 55 R. 35E M. WM

Tract or Surv. No.

3/16 Cor. of
SECT. 19 & 20