

Index
File No. X-19

CORNER RECORD (SEARCH)

(Ref. FSM 7151.4)

Tract or Survey No. _____ Cor. No. _____


T 55 R. 34E

R.D. LA GRANDE County UNION

Merid. WILLAMETTE

N.F. WILLOWA-WHITMAN State OREGON

CORNER DIAGRAM

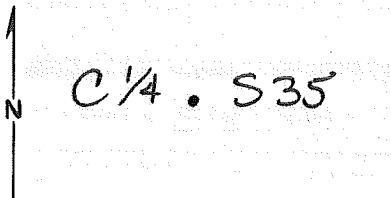

DESCRIBE CORNER MONUMENT FOUND

NONE

DESCRIBE BEARING TREES OR OTHER OFFICIAL ACCESSORIES FOUND

NONE

PHOTO IDENTIFICATION DATA

Photo No. _____
Filed At. _____
Object Ident. _____
Ident. By _____
Signature

DESCRIBE CORNER LOCATION RELATIVE TO NEAR-BY FEATURES, ALSO HOW TO REACH CORNER

CORNER IS FOUND 850 FT. SW OF RD. 5160-000
LOCATION POSTER ON 12" FIR ON SOUTH SIDE OF
RD. 5160 SAYS CORNER IS N25°E, 175 FT.

PLANE COORDINATE POSITION DATA

State _____ Zone _____
X _____
Y _____
Estab. By _____
Agency

Signature

Title
LS 1844

Division

Headquarters

Date
8/25/84

FS-7100-52 (3/68)

CORNER RECORD (PERPETUATION)

MONUMENT: DESCRIBE NEW MONUMENT SET, OR WORK DONE TO PRESERVE EXISTING MONUMENT

SET 2 1/2" ALUMINUM CAP ON 2 3/8" ALUMINUM PIPE
RISING 6" ABOVE GROUND.

SET STEEL FENCE POST 3.0 FT. NORTH OF CORNER.

T5S R34E
C 1/4 • S35
RLS 1844
1984

ACCESSORIES: DESCRIBE NEW BT'S WITNESS OBJECTS ETC. ESTABLISHED, OR WORK DONE TO PRESERVE EXISTING EVIDENCE

A 5" FIR BEARS N50 1/2° W, 37.1 FT. B 1/2 S C 1/4 S35 BT.

A 6" TAMARACK BEARS S79° W, 42.3 FT. B 1/2 S C 1/4 S35 BT.

PAINTED 6" RED BANDS & ATTACHED SIGNS

Work Done By D.E. SCOTT Title SURVEYOR Date 8/25/84 State Registration No. LS 1844
or Agency

Certified Cor. Record Prepared? Yes X No Filed At: UNION CO. SURVEYOR'S OFFICE Date

REMARKS

Index File No.

T.5S

R.34E

W.M.

Tract or Surv. No.

Cor.

X-19