

**OREGON CORNER RESTORATION FORM**

Section 26 Township 6N Range 33E  
 County Umatilla Date: March 31, 2003

Corner Designation: 6N33V17

Corner to sections 26, 27, 34, and 35, T6N, R33E,  
 W.M., Umatilla County, Oregon.


Previous Renewals / Surveys, etc.

Corner originally set by Nicholas O. Walden under Contract No. 209 dated July 6th, 1874. His record reads: Set basalt stone, 18 x 9 x 6, 9 ins. in ground for Cor. to Secs. 26, 27, 34, & 35.


Condition Report Only  
 Not found  
 Remonumented  
 Unrecorded  
 Surveyed in  
 Referenced out

Monument and Accessories found: ( condition and source )

A wooden post in a mound of stone with old fence jacks running South and Southeast and online with a fence running to the West. The stones had been painted.

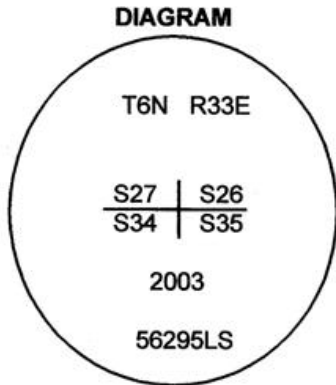

- ⊗ = 1" Iron Rebar
- = Guard post
- = Iron rebar reference

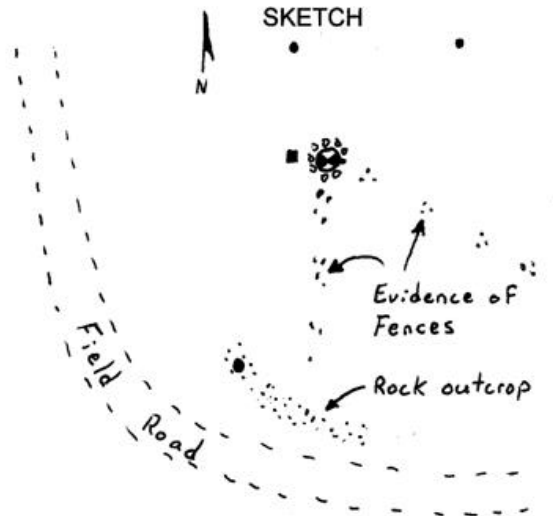

**MONUMENT (S) AND ACCESSORIES SET (Procedures and Description)**

I drove a 1" x 24" iron rebar with a 2" aluminum cap stamped as shown in the diagram above into the bedrock in the mound of stone. I set a 5' steel guard post with a County monument sign attached along side.

For references, I set four, 5/8" by 24" green coated, iron rebars with 1.25" orange plastic caps stamped WTS and 56295LS attached as described below:

- a rebar bears N39°15'29"E, 70.46 feet;
- a rebar bears S72°46'33"E, 133.85 feet;
- a rebar bears S33°47'48"W, 81.16 feet in a small rock outcrop;
- a rebar bears N14°51'41"W, 57.79 feet;

The monument and references were tied using a LIECA system 300 RTK GPS.

Location and comments  
 NAD 83-91 coordinates from a single  
 GPS tie to Tri Station GEER.

N 843268.03  
 E 8669274.75  
**RECEIVED BY:**  
Umatilla County Surveyor  
 Date: 11-03  
 Rec'd By: KR  
 No. 03-315-C

Compass Declination  
 Firm / Agency  
 Witness Tree Surveying  
 Address  
 P.O. Box G  
 Pilot Rock, Or. 97868  
 Party Chief  
 Stephen K. Haddock

Surveyors Seal

REGISTERED  
 PROFESSIONAL  
 LAND SURVEYOR

*Stephen K. Haddock*

OREGON  
 JULY 9, 2001  
 STEPHEN K. HADDOCK  
 56295LS

RENEWAL DATE 6-30-05