

**OREGON CORNER RESTORATION FORM**

Section 35 Township 6N Range 33E  
 County Umatilla Date: April 01, 2003

Corner Designation: 6N33Z21

Corner to sections 35 & 36, T6N, R33E, and sections 1 & 2, T5N, R33E, W.M., Umatilla County, Oregon.



Condition Report Only  
 Not found  
 Remonumented  
 Unrecorded  
 Surveyed in  
 Referenced out

Previous Renewals / Surveys, etc.

Corner originally set by Wm. H. Odell and Wm. S. Lewis under contract No. 110 dated February 7th 1865. Their record reads: Set post Cor. for Secs. 1, 2, 35, & 36. Drove Charred Stake, dug pits and raised mound as per instructions. This corner was visited by John Kimbrell under the survey recorded in Book 2, Page 36 of the record of private surveys. Mr. Kimbrell records visiting the corner but does not identify it.

Monument and Accessories found: ( condition and source )

A basalt stone 15 x 12 x 10 with an (x). The stone was set over charcoal. The stone was firmly in place about 4.5 feet south of a three way fence intersection with fences North, West and East.

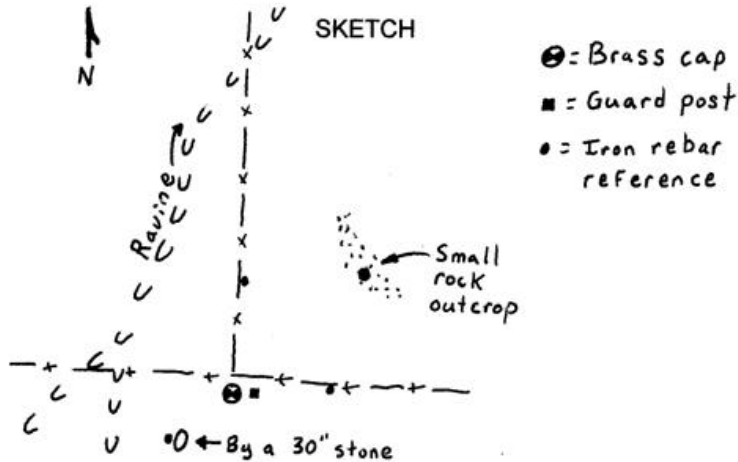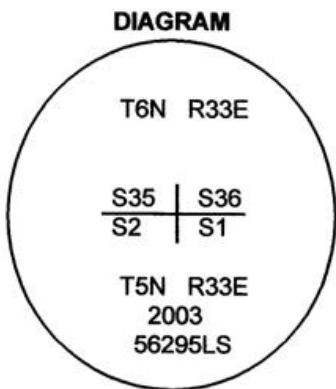

**MONUMENT (S) AND ACCESSORIES SET (Procedures and Description)**

I set a 1 1/2" x 30" galvanized iron pipe with a 2 1/4" Brass cap stamped as shown in the diagram above at the position of the stone. I set a 5' steel guard post with a County monument sign attached along side. I buried the stone along side.

For references, I set four, 5/8" by 24" green coated, iron rebars with 1.25" orange plastic caps stamped WTS and 56295LS attached as described below:

- a rebar bears N33°40'47"E, 133.09 feet in a small rock outcrop;
- a rebar bears N00°04'45"W, 33.13 feet under the existing fence;
- a rebar bears N78°23'37"E, 24.86 feet under the existing fence;
- a rebar bears S53°36'38"W, 48.19 feet;

The monument and references were tied using a LIECA system 300 RTK GPS.

Location and comments  
 NAD 83-91 coordinates from a single  
 GPS tie to Tri Station GEER.

N 836385.37  
 E 8674687.80  
**RECEIVED BY:**  
Umatilla County Surveyor  
 Date: 11-03  
 Rec'd By: KK  
 No. 03-315-C

Compass Declination  
 Firm / Agency  
 Witness Tree Surveying  
 Address  
 P.O. Box G  
 Pilot Rock, Or. 97868  
 Party Chief  
 Stephen K, Haddock

Surveyors Seal

**REGISTERED  
 PROFESSIONAL  
 LAND SURVEYOR**

*Stephen K. Haddock*

OREGON  
 JULY 9, 2001  
**STEPHEN K. HADDOCK**  
 56295LS

RENEWAL DATE 6-30-05