

**OREGON CORNER RESTORATION FORM**

Section 14 Township 6N Range 35E  
 County Umatilla Date: May 25, 2011

Corner Designation: 6N35L21


Quarter corner to sections 13 and 14, T6N, R35E, W.M.  
 Umatilla County, Oregon.

Condition Report Only  
 Not found  
 Remonumented  
 Unrecorded  
 Surveyed in  
 Referenced out


Previous Renewals / Surveys, etc.

The corner was originally set by Odell and Lewis under contract No. 110 dated February 7, 1865. Their record reads: Set 1/4 Sec. post corner. Drove charred stake; dug pits & raised mound, as per instructions. A position for this corner was computed in survey 86-14-A but no monument was set.

Monument and Accessories found: ( condition and source )  
 None.

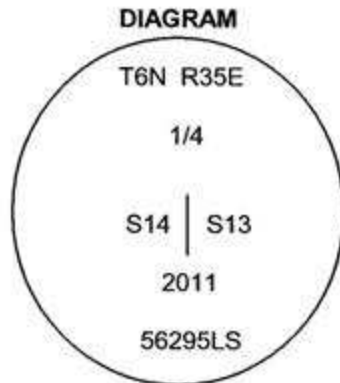

- = Railroad Tie Fence post
- ⊙ = Brass Cap
- = Iron Rebar Reference

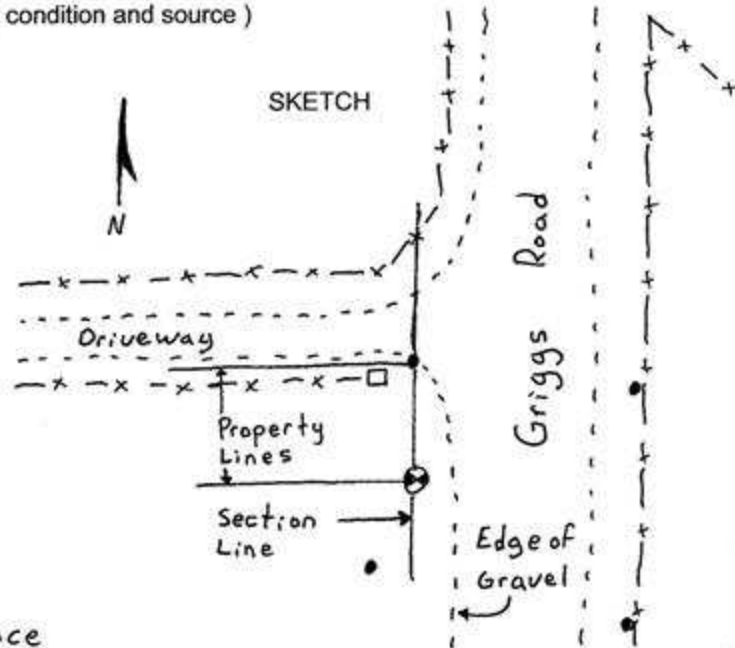

**MONUMENT (S) AND ACCESSORIES SET (Procedures and Description)**

I set a 2 1/4" brass cap on a 1 1/2" x 30" galvanized iron pipe at the proportioned point. The top of the monument is 22" below the surface in the west bank of Griggs Road and is stamped as shown in the diagram above.

For references I set four 5/8" x 24" iron rebars with 1 1/8" orange plastic caps stamped WTS and 56295LS as described below:

- an iron rebar bears N00°39'55"S, 18.44 feet at the SE corner of the land described in Reel 535, Page 679 of the Umatilla County Deed Records.
- an iron rebar bears N63°56'35"E, 30.45 feet at the foot of a railroad tie fence post;
- an iron rebar bears S50°32'26"E, 34.90 feet;
- an iron rebar bears S25°05'31"W, 14.96 feet 20" below the surface of a plowed field;

The monument was set and references were set and tied using a Trimble R7/R8 RTK GPS

Location and comments

Compass Declination

Surveyors Seal

RECEIVED BY:  
 Umatilla County Surveyor  
 Date: 6/20/2011  
 Rec'd By: [Signature]  
 No. 11-064-B

Firm / Agency  
 Witness Tree Surveying  
 Address  
 P.O. Box G  
 Pilot Rock, Or. 97868  
 Party Chief  
 Stephen K, Haddock

REGISTERED  
 PROFESSIONAL  
 LAND SURVEYOR

*Stephen K. Haddock*

OREGON  
 JULY 9, 2001  
 STEPHEN K. HADDOCK  
 56295LS

RENEWAL DATE 6-30-13