

OREGON CORNER RESTORATION FORM

Section 27 Township 6N Range 36E

County Umatilla Date 7/1/03

CORNER DESIGNATION

R-13 (NORTHWEST CORNER)

- Condition Report Only
- Not Found
- Renewed
- Unrecorded
- Surveyed In
- Referenced Out

Previous Renewals/Surveys, etc.:

Odell and Lewis, under Contract No. 110, dated February 7, 1865, drove charred stake, dug pits, and raised mound.


John Kimbrell, County Surveyor, in his 1899 survey for Fred Stine, Book 1, Pages 401-402, Record of Private Surveys, refers to the corner as a stone in the road, though he doesn't say whether he found it or set it.

Monument(s) & Accessories Found: (Condition and Source)

None

Monument Detail

Monument is a railroad spike stamped "LS2627" with punch mark set flush with asphalt road surface.

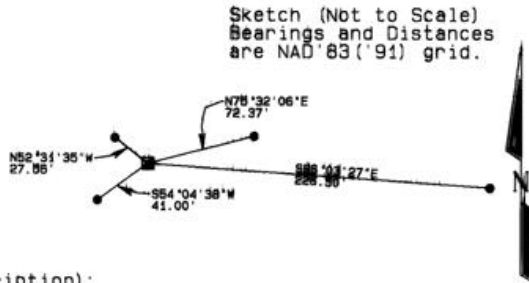

Monument Set (Procedures and Description):

Set the spike at the location determined by holding the center of the asphalt surface of Birch Creek Road for northing and proportioning between the Tomkins brass cap at the Northwest Corner of Section 28 and the monument I set at the Northeast Corner of Section 27 for easting based on G.L.O. records.

New Accessories:

- A 5/8" X 30" iron rebar with yellow plastic cap marked "UCPWD...LS2627" bears S54°04'38"W, 41.00' (a power pole with bearing object tag attached bears 1' +/- southwesterly from pin).
- A 5/8" X 30" iron rebar with yellow plastic cap marked "UCPWD...LS2627" bears S86°03'27"E, 228.50' (the remains of a power pole with bearing object tag attached bears 1' +/- southeasterly from pin).
- A 5/8" X 30" iron rebar with yellow plastic cap marked "UCPWD...LS2627" bears N52°31'35"W, 27.56' (a bearing object tag is attached to pin).
- A 5/8" X 30" iron rebar with yellow plastic cap marked "UCPWD...LS2627" bears N75°32'06"E, 72.37' (a bearing object tag is attached to pin).

Location and Comments: Compass Declination: N/A

From the intersection of Powerline Road and Birch Creek Road travel east approximately 1/4 mile. The monument is set flush with the asphalt surface of Birch Creek Road.

Firm/Agency :  
Umatilla County  
Road Department

Address:  
3920 Westgate  
Pendleton, Oregon 97801

Party Chief:  
Gary Roberts

Notes:  
Gary Roberts

Witness:  
None

Surveyor's Seal

REGISTERED  
PROFESSIONAL  
LAND SURVEYOR

*Gary R. Roberts*

OREGON  
JULY 20, 1993  
GARY R. ROBERTS  
2627

RENEWS 12/31/2004

Oregon State Plane Coordinates  
NAD '83 ('91) - International Feet

Northing: 849,701.89

Easting: 8,759,049.82

03-105-C