

**OREGON CORNER RESTORATION FORM**

Section 34 Township 6N Range 36E  
 County Umatilla Date: November 20, 2007

Corner Designation: 6N36V17

Corner to sections 26, 27, 34, and 35, T6N, R36E,  
 W.M., Umatilla County, Oregon.

Condition Report Only  
 Not found  
 Remonumented  
 Unrecorded  
 Surveyed in  
 Referenced out



Previous Renewals / Surveys, etc.

Corner originally set by Odell and Lewis under contract No. 110 dated February 7, 1865: Their record reads: Set post Cor. for Secs. 26, 27, 34 & 35. Drove charred stake, dug pits & raised mound as per instructions.

The road notes for County Road 19 indicates that this road began at this corner.

Monument and Accessories found: ( condition and source )

None. The point falls at the intersection of the County Road to the North and a plow berm east.

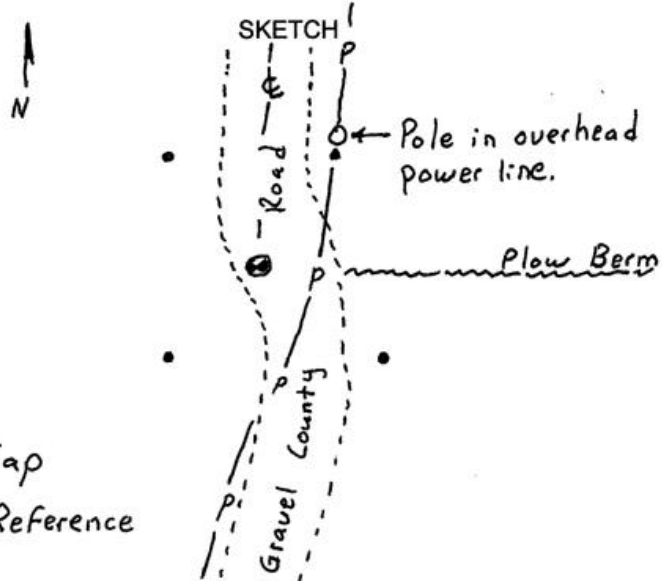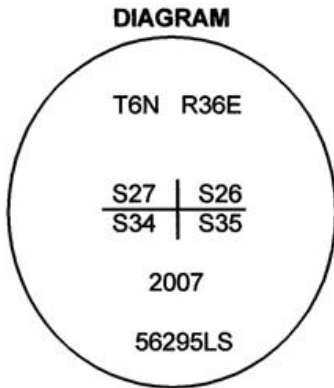

⊙ = Brass Cap  
 ● = Rebar Reference

**MONUMENT (S) AND ACCESSORIES SET (Procedures and Description)**

I set a 1 1/2" x 30" galvanized iron pipe with a 2 1/4" brass cap stamped as shown in the diagram above at the intersection of the County Road and the plow berm to the east. The cap is approximately 8" below the surface of the road.

For references, I set four, 5/8" by 24" rebars with 1 1/8" orange plastic caps attached, stamped WTS and 56295LS as described below:

- an iron rebar bears N43°41'19"E, 26.01 feet ;
- an iron rebar bears N64°06'37"W, 26.48 feet, 18" below the surface of a plowed field;
- an iron rebar bears S48°25'01"W, 32.95 feet, 18" below the surface of a plowed field;
- an iron rebar bears S53°44'16"E, 55.32 feet, 10" below the surface of a plowed field;

The monument and references were tied using a Trimble R7/R8 RTK GPS.

Location and comments

Compass Declination

Surveyors Seal

RECEIVED BY:  
Umatilla County Surveyor  
 Date: 02-08  
 Rec'd By: [Signature]  
 No. 08-039-C

Firm / Agency  
 Witness Tree Surveying  
 Address  
 P.O. Box G  
 Pilot Rock, Or. 97868  
 Party Chief  
 Stephen K, Haddock

REGISTERED  
 PROFESSIONAL  
 LAND SURVEYOR

*Stephen K. Haddock*

OREGON  
 JULY 9, 2001  
 STEPHEN K. HADDOCK  
 56295LS

RENEWAL DATE 6-30-09