

**OREGON CORNER RESTORATION FORM**

Section 34 Township 6N Range 36E  
 County Umatilla Date: November 20, 2007

Corner Designation: 6N36Z13


Corner to sections 33, 34, T6N, and 3, and 4, T5N, R36E, W.M., Umatilla County, Oregon.

Previous Renewals / Surveys, etc.


Corner originally set by Odell and Lewis under contract No. 110 dated February 7, 1865. Their record reads: Set post Cor. for Secs. 3, 4, 33 & 34. Drove charred stake, dug pits & raised mound as per instructions.

Monument and Accessories found: (condition and source)  
 A 1/2" smooth iron pin of unknown origin.

Condition Report Only  
 Not found  
 Remonumented  
 Unrecorded  
 Surveyed in  
 Referenced out

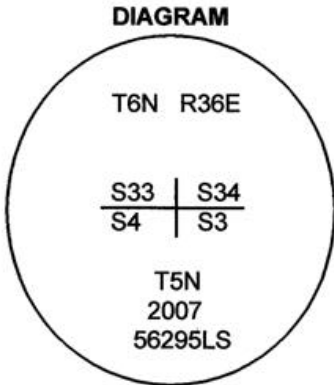

⊗ = Brass Cap  
 ● = Rebar Reference

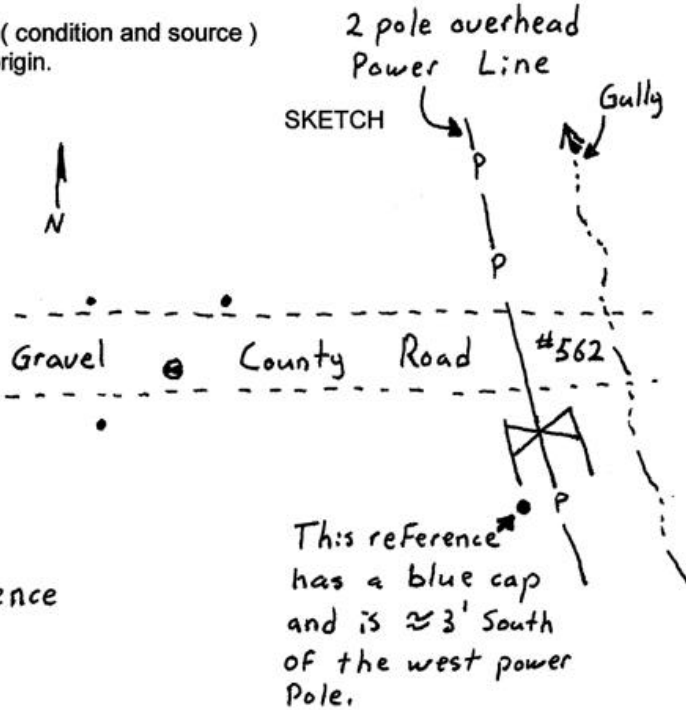

**MONUMENT (S) AND ACCESSORIES SET (Procedures and Description)**

At the position of the 1/2" pin I set a 1 1/2" x 30" galvanized iron pipe with a 2 1/4" brass cap stamped as shown in the diagram above. I buried the pin along side the cap. The cap is approximately 8" below the surface of the road.

For references, I set four, 5/8" by 24" rebars with 1 1/8" orange plastic caps attached, stamped WTS and 56295LS as described below:

- an iron rebar bears N43°59'32"W, 28.07 feet, 18" below the surface of the plowed field;
- an iron rebar bears N47°07'34"E, 26.67 feet, 18" below the surface of a plowed field;
- an iron rebar bears S57°15'52"W, 27.49 feet, 18" below the surface of a plowed field;
- an iron rebar bears S78°16'13"E, 227.53 feet, about 2' south of a power pole. This pin has a blue plastic cap attached.

The monument and references were tied using a Trimble R7/R8 RTK GPS.

Location and comments

Compass Declination

Surveyors Seal

RECEIVED BY:  
Umatilla County Surveyor  
 Date: 02-08  
 Rec'd By: [Signature]  
 No. 08-039-C

Firm / Agency  
 Witness Tree Surveying  
 Address  
 P.O. Box G  
 Pilot Rock, Or. 97868  
 Party Chief  
 Stephen K, Haddock

REGISTERED  
 PROFESSIONAL  
 LAND SURVEYOR

*Stephen K. Haddock*

OREGON  
 JULY 9, 2001  
 STEPHEN K. HADDOCK  
 56295LS

RENEWAL DATE 6-30-09