


Index
File No. R20

CORNER RECORD (SEARCH)
(Ref. FSM 7151.4)

Tract or
Survey No. _____ Cor.
No. _____

T. 6N R. 38E R.D. Walla Walla County Umatilla
Merid. Willamette N.F. Umatilla State Oregon

CORNER DIAGRAM

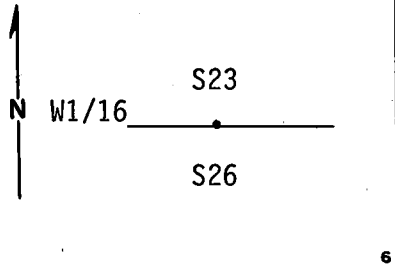

DESCRIBE CORNER MONUMENT FOUND

Found 3" BLM brass cap 4" above ground. Stamped "1991"

DESCRIBE BEARING TREES OR OTHER OFFICIAL ACCESSORIES FOUND

- 1) Found 13" scribed Fir with 54-3 sign reading T6N R38E Sec.23 S 36°W 30½ lks. RJ 8/91
- 2) Found 12" scribed Fir with 54-3 sign reading T6 N R38 E Sec. 26, N 2½°E 47½lks RJ 8/91
- 3) Found dead 24" tree with location poster on ridge south of corner.

PHOTO IDENTIFICATION DATA

Photo No. _____
Filed At. _____
Object Ident. _____
Ident. By _____
Signature

DESCRIBE CORNER LOCATION RELATIVE TO NEAR-BY FEATURES, ALSO HOW TO REACH CORNER

Head 1½ mile from upper switchback on Tiger Canyon Road to wood post with location poster. Head north 900' to corner.

PLANE COORDINATE POSITION DATA

State _____ Zone _____
X _____
Y _____
Estab. By _____
Agency

Signature

PAUL TOMKINS

Title

PLS 2360

Division

Headquarters

Date

7/1992

FS-7100-52 (3/68)

CORNER RECORD (PERPETUATION)

MONUMENT : DESCRIBE NEW MONUMENT SET, OR WORK DONE TO PRESERVE EXISTING MONUMENT

Cleared Brush

ACCESSORIES : DESCRIBE NEW BT'S, WITNESS OBJECTS ETC. ESTABLISHED, OR WORK DONE TO PRESERVE EXISTING EVIDENCE

9

Work Done By _____ Title _____ Date _____ State Registration No. or Agency _____

10

Certified Cor. Record Prepared ? Yes (No) Filed At: _____ Date _____

11

REMARKS

Index File No. r20 T. 6N R. 38E M. W.M. Tract or Surv. No. Cor. _____

12

13