


**HISTORY OF ORIGINAL CORNER ESTABLISHMENT:**

This record has been prepared to provide current information regarding the condition of the corner monument and accessories as described in the survey records cited below. Verification of the position of the corner monument and dimensions to existing accessories, and the establishment of new corner accessories was not performed as part of this visit.

The source of the monumentation and dimensions cited in this record is a Dependent Resurvey of ...Portions of the South and East Boundary, and Subdivisional Lines of Township 6 North, Range 38 East, Willamette Meridian, conducted by the Bureau of Land Management, commenced on October 13, 1987, and completed September 16, 1991.

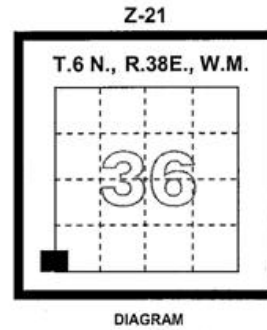

**RECORD DESCRIPTION OF CORNER MONUMENT AND ACCESSORIES:**

From the BLM Dependent Resurvey:

The corner of secs. 35 and 36 only, monumented with an iron post, 2 ins. diam., firmly set in mound of stone, 4 ft. base to top, with brass cap mkd. (See diagram below), from which the remains of an original bearing tree:

A spruce snag, 6 ins. diam., bears N4 1/2°W 49 lks. dist., no marks (Record N2°E 48 lks.), and the remains of a bearing tree mkd. by Gould:

A fir stump, 24 ins. diam., bears N37 1/2°E 107 1/2 lks. dist., with scribe marks 6N R38E BT on partially healed and rotted blaze (Record N42 1/2°E 110 lks.), and new bearing trees:

A spruce, 7 ins. diam., bears N11 1/2°E 41 1/2 lks. dist., mkd. T6N R38E S36 BT,  
 A spruce, 9 ins. diam., bears N21 3/4°W 58 lks. dist., mkd. T6N R38E S35 BT,

The corner is located on Indian Ridge, bears N10°E and S10°W.

**DESCRIPTION OF MONUMENT AND ACCESSORIES FOUND AT THIS CORNER LOCATION:**

**Found:**

A 2 1/2" brass cap, marked as shown, on a 2" iron pipe, extending 15" above ground and in a mound of stone 4' dia. And 1.5' high, on open ridgetop, from which:

The original bearing tree (N4 1/2°W as described by BLM 1991) was not found,

A fir stump, rotten and size indeterminate, with scribing "T6N" visible (Gould NE bearing tree),

A 10" Fir snag, 7' tall, with scribing "T6N R38E S36 BT" visible on a deteriorated single blaze (BLM 1991 NE bearing tree),

A 6" Subalpine Fir snag, 15' tall, with scribing "T6N R38E S35 BT" visible on deteriorated blaze (BLM 1991 NW bearing tree),

Additionally, we find the following corner accessories, for which we find no information in the Umatilla County, Oregon survey records, regarding their history:

A 16" Grand Fir, standing dead, with scribing "T6N R38E S36 BT" and brass washer mkd. "OR 2360 WA 25893" visible on unhealed single blaze (NE quadrant),

And a 32" Douglas Fir, standing dead, with healed blaze and bearing tree tag marked "PLS 1636 3-18-81" (SW quadrant).



REGISTERED  
PROFESSIONAL  
LAND SURVEYOR

*A.M. [Signature]*

OREGON  
JAN. 21, 1992  
HARMON E. McLENDON  
2537

Renews 12/31/06

I hereby certify that the above corner position was visited and found as described on October 17, 2005.

Witnesses: Tim Johnson, Gary Langlitz, Jeremy Jones

RECEIVED BY  
Umatilla County Surveyor  
Date 1-06  
Rec'd by KK  
No. 06-13-2