


A-14

CERTIFIED RECORD OF LAND CORNER MONUMENTATION

History of original corner establishment:
Unsurveyed - subdivided section

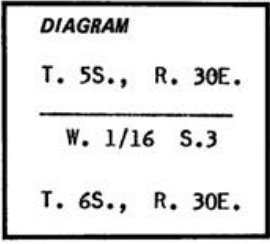


Description of corner evidence found:
None.

Description of monument and accessories | established to perpetuate the original location of this corner:

Set 2 1/2" x 30" iron pipe with a brass cap marked as shown:
From which I scribed Bearing Trees.

A 11" pine bears S. 22°55' W. 39.6 ft. mkd. W. 1/16 S.3 cc BT.
A 8" pine bears S. 33°28' E. 13.5 ft. mkd. W. 1/16 S.3 cc BT.

Nailed a brass washer mkd. PLS 933 to the BT blaze of both trees.
Set steel fence post 3 ft. East of corner. Corner is 5 ft. South of E-W fence line. Used transit and steel tape measuring to the center of BTs.

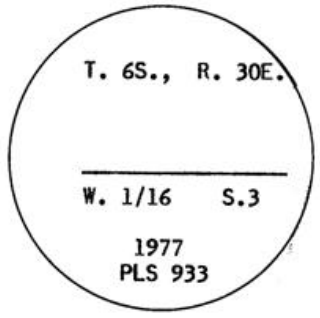

Office of.....County Surveyor..... County of.....Umatilla.....
 State of.....Oregon....., I hereby certify that the within instrument was filed in this office
 for record on the..... day of....., 19.....
David H. Krumbein by.....
 (COUNTY OFFICIAL) (DEPUTY)

A-14

m-64