

USDA-FOREST SERVICE

Index

File No. A-19

T6S

R30E

Merid. Willamette

CORNER RECORD (SEARCH)

Ref. FSM 7151.4

R.D. North Fork John Day

N.F. Umatilla

Tract or

Survey No

County Umatilla

State Oregon

Cor.

No.

x

Corner Diagram T6S R30E

C1/4

T

C S2

1977

PLS 933

x

Photo Identification Data

Photo No.

filed at

Object Ident.

Ident. by

Signature

x

Plane Coordinate Position Data

State

Zone

X

Y

Estab. by

Agency

x

Signature

David L. Haddock

Title

Land Surveyor

Division

Headquarters

Pendleton, OR

Date

June 1988

7100.52

1 Describe corner monument found
 1 Steel pipe extending 4" above the ground with a 2 1/2" brass cap stamped as
 1 shown in the diagram.

1 Describe bearing trees or other official accessories found
 1 A 14" Lodgepole Pine bears S41°12'E, 55.7' with healed scribe.
 1 A 9" White Fir bears S67°54'W, 47.4' with healed scribe.

1 Describe corner location relative to near-by features, also how to reach corner
 1 From the junction of roads 5312 and 5320, follow 5320 east 1.6 miles to road
 1 5320110. Then follow road 5320110 east 0.9 miles to road 5320115. Follow road
 1 5320115 0.3 miles south to the an east-west fence. Follow the fence west
 1 approximately 200' to the corner.

CORNER RECORD (PERPETUATION)

X _____ X
 Monument: Describe new monument set, or work done to preserve existing monument

None

X _____ X
 Accessories: Describe new BT's witness objects etc. established, or work done to preserve existing evidence

None

X _____ X
 Work done by David L. Haddock Title Land Surveyor Date State Registration No.
 Certified cor. record prepared? yes no x Filed at or Agency 852
 Date

X _____ X
 REMARKS

X _____ X
 Index File No. A-19 T.6S. R.30E. M. Willamette Tract or Survey No Cor.

USDA-FOREST SERVICE

Index
File No. A-19
T 6S. R. 30E.
Merid. Willamette


CORNER RECORD (SEARCH)

(Ref. FSM 7151.4)

Tract or
Survey No. _____ Cor.
No. _____

R.D. Ukiah County Umatilla
N.F. Umatilla State Oregon

CORNER DIAGRAM

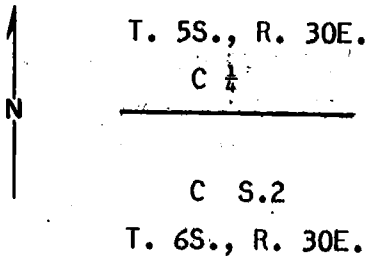

DESCRIBE CORNER MONUMENT FOUND

None
Set brass cap

DESCRIBE BEARING TREES OR OTHER OFFICIAL ACCESSORIES FOUND

None

PHOTO IDENTIFICATION DATA

Photo No. _____
Filed At. _____
Object Ident. _____
Ident. By _____
Signature

DESCRIBE CORNER LOCATION RELATIVE TO NEAR-BY FEATURES, ALSO HOW TO REACH CORNER

From the intersection of U. S. Forest Road 419N and 537N, go East along 537N to Gulliford Crossing 1.8 miles, then East 1.6 miles, then walk South 15.2 chns. to corner.

PLANE COORDINATE POSITION DATA

State _____ Zone _____
X _____
Y _____
Estab. By _____
Agency

Signature
David H. Kunkin

Title _____ Division OPLS Headquarters 933 Date 7-77
7100-52-(3/68)

CORNER RECORD (PERPETUATION)

MONUMENT: DESCRIBE NEW MONUMENT SET, OR WORK DONE TO PRESERVE EXISTING MONUMENT

T. 6S., R. 30E.

C $\frac{1}{4}$

Set 2½" x 30" iron pipe with brass cap.

C S.2

Pipe is 22" in ground.

1977 1977

Stamped:

PLS 933

ACCESSORIES : DESCRIBE NEW BT'S WITNESS OBJECTS ETC. ESTABLISHED, OR WORK DONE TO PRESERVE EXISTING EVIDENCE

A 14" pine bears S. 41°12' E. 55.7 ft.

A 9" fir bears S. 67°54' W. 47.4 ft.

Set steel fence post 4 ft. West of corner w/sign.

Painted red band around BT trees w/sign.

Work Done By T. Hamby Title Party Chief Date 6/23/77 State Registration No. _____
or Agency _____Certified Cor. Record Prepared? Yes No Filed At: _____ Date _____

REMARKS

Index File No.

T.

R.

M.

Tract or Surv. No.

Cor.

12

13