

USDA-FOREST SERVICE

Index File No. A-25

CORNER RECORD (SEARCH)

(Ref. FSM 7151.4)

Tract or Survey No. _____ Cor. No. _____

T 6S. R. 30E.


R.D. Ukiah County Umatilla

Merid. Willamette

N.F. Umatilla State Oregon

CORNER DIAGRAM

T. 5S., R. 30E.
S. 35

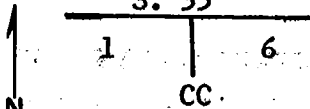

T. 6S. R. 30E.
R. 30E. R. 31E.

DESCRIBE CORNER MONUMENT FOUND

None

Set brass cap

DESCRIBE BEARING TREES OR OTHER OFFICIAL ACCESSORIES FOUND

None

PHOTO IDENTIFICATION DATA

Photo No. _____
Filed At. _____
Object Ident. _____
Ident. By _____

Signature

PLANE COORDINATE POSITION DATA

State _____ Zone _____
X _____
Y _____
Estab. By _____

Agency

DESCRIBE CORNER LOCATION RELATIVE TO NEAR-BY FEATURES, ALSO HOW TO REACH CORNER

From the intersection of U.S. Forest Road 419N and 537N, go East 1.8 miles to Gulliford crossing, then East 2.2 miles, then along a fence 39.0 chns. to corner.

Signature
David H. Kula

Title _____ Division OPLS Headquarters 933

Date
7-77

7100-52-(3/68)

CORNER RECORD (PERPETUATION)

MONUMENT: DESCRIBE NEW MONUMENT SET, OR WORK DONE TO PRESERVE EXISTING MONUMENT

Set 2½" x 30" iron pipe with brass cap.
Pipe is 28" in ground.

T. 3S.

S.36

S.1 S.6

R. 30E. R. 31E.

T. 6S.

1977 PLS 933

Stamped:

ACCESSORIES : DESCRIBE NEW BT'S WITNESS OBJECTS ETC. ESTABLISHED, OR WORK DONE TO PRESERVE EXISTING EVIDENCE

A 22" pine bears S. 40°21' W. 42.4 ft.
A 18" fir bears S. 87°35'E. 62.0 ft.

Set steel fence post 3 ft. West of corner.w/sign.
Painted red band around bearing trees w/sign.

Work Done By T. Hamby Title Party Chief Date 6/23/77 State Registration No. _____
or Agency _____

Certified Cor. Record Prepared ? Yes No Filed At: _____ Date _____

REMARKS

Index File No.

T.

R.

M.

Tract or Surv. No.

Cor.

12

13