

Index  
File No. A-3

**CORNER RECORD (SEARCH)**

(Ref. FSM 7151.4)

Tract or  
Survey No. \_\_\_\_\_ No. 1/4 Cor. \_\_\_\_\_


T 6S R. 30E

R.D. Ukiah County Umatilla

Merid. Willamette

N.F. Umatilla State Oregon

**CORNER DIAGRAM**

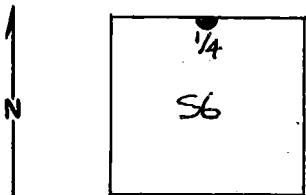

**DESCRIBE CORNER MONUMENT FOUND**

None

**DESCRIBE BEARING TREES OR OTHER OFFICIAL ACCESSORIES FOUND**

None

**PHOTO IDENTIFICATION DATA**

Photo No. \_\_\_\_\_

Filed At. \_\_\_\_\_

Object Ident. \_\_\_\_\_

Ident. By \_\_\_\_\_

*Signature*

**PLANE COORDINATE POSITION DATA**

State \_\_\_\_\_ Zone \_\_\_\_\_

X \_\_\_\_\_

Y \_\_\_\_\_

Estab. By \_\_\_\_\_

*Signature*

**DESCRIBE CORNER LOCATION RELATIVE TO NEAR-BY FEATURES, ALSO HOW TO REACH CORNER**

Corner is South of road along Std. Parallel and visible from same

PLS

346

9/79

Title

Division

Headquarters

Date

7100-52-(3/68)

## CORNER RECORD (PERPETUATION)

MONUMENT: DESCRIBE NEW MONUMENT SET, OR WORK DONE TO PRESERVE EXISTING MONUMENT

Set 32" X 2" Flanged iron pipe with brass cap marked:

T5S R29E

 $\frac{1}{4}$  S6

T6S R30E

1979

PLS 346

ACCESSORIES : DESCRIBE NEW BT'S WITNESS OBJECTS ETC. ESTABLISHED, OR WORK DONE TO PRESERVE EXISTING EVIDENCE

Ponderosa Pine, 8" Dia., BRS. S39<sup>0</sup>E., 69.2 Ft. Distance.Ponderosa Pine, 16" Dia., BRS. S 2 $\frac{1}{2}$ <sup>0</sup>W., 79.8 Ft. Distance.

6' Iron Fence Post with "Survey Monument" sign within 5' of Corner.

Work Done By Wayne O. Harris Title PLS Date 9/79 State Registration No. 346  
or AgencyCertified Cor. Record Prepared? YES NY Filed At: Umatilla Co. Surveyor Office Date

REMARKS

Index File No. A-3 T. 6S R. 30E W.M. W.M. Tract or Surv. No.Cor.  $\frac{1}{4}$  6