


CERTIFIED RECORD OF LAND CORNER MONUMENTATION

6-11

History of original corner establishment:

Unsurveyed - Subdivided section

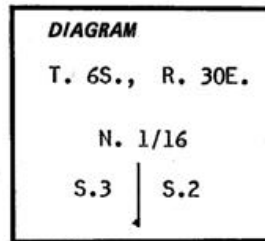

No record of subsequent remonumentation found in County Records.

Description of corner evidence found:


None.

Description of monument and accessories established to perpetuate the original location of this corner:

Set 2 1/2" x 30" iron pipe 27" in ground with brass cap marked as follows: From which I scribed Bearing Trees.

A 8" pine bears N. 52° E. 35.1 ft. mkd T.6 s., R130 E., N. 1/16 S2 BT  
A 10" fir bears S. -70° W. 36 ft. mkd T.6 S, R. 30 E. N. 1/16 S3 BT

Nailed a brass washer mkd. PLS 933 to the BT blaze of both trees. Set a steel fence post 2 ft. West of corner. Used compass with 20° East variation and steel tape, measuring to the center of BTs.

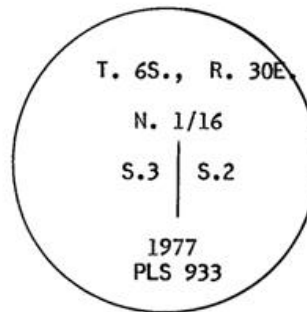

Office of.....County Surveyor..... County of.....Umatilla.....  
 State of.....Oregon....., I hereby certify that the within instrument was filed in this office  
 for record on the..... day of....., 19.....  
*David H. Krumbein* by.....  
 (COUNTY OFFICIAL) (DEPUTY)

B-17

71-64