


CERTIFIED RECORD OF LAND CORNER MONUMENTATION

D-21

History of original corner establishment:

Unsurveyed - subdivided section

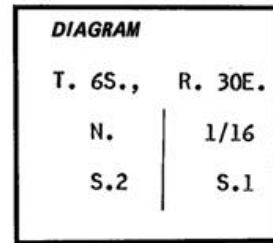

No record of subsequent remonumentation found in County Records.

Description of corner evidence found:


None.

Description of monument and accessories I established to perpetuate the original location of this corner:

Set 2½" x 30" iron pipe 16" in ground with a brass cap marked as shown:
From which I scribed Bearing Trees.

A 10" pine bears S. 87°54' W. 54.5 ft. mkd. N. 1/16 S.2 BT.
A 10" pine bears N. 55°26' E. 27.7 ft. mkd. N. 1/16 S.1 BT.

Nailed a brass washer mkd. PLS 933 on the BT blaze on both trees.
Set steel fence post 4 ft. North of corner. Raised a stone mound
4 ft. base within 2" to top of pipe. Used transit and steel tape,
measuring to the center of BT.

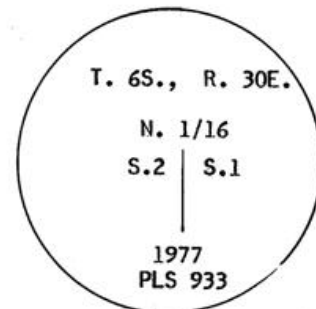

Office of.....County Surveyor..... County of.....Umatilla.....
 State of.....Oregon..... I hereby certify that the within instrument was filed in this office
 for record on the.....10..... day of.....August....., 19.....
David H. Krumbein by.....
 (COUNTY OFFICIAL) (DEPUTY)

B-21

m-65