

LAND CORNER RECORD

5680-2

1. T 6S R29E No. C-25 Cor. 1/4 Mer W. State Oregon (Rectangular) N. F. Umatilla Dist. Ukiah 4

2. Corner Status

3. Original Description \_\_\_\_\_ Vol. \_\_\_\_\_ Page 145 Where Recorded 9.2.121

4. Description of Corners: Corner is a post from which:  
 a 10" Fir Brs. S.87°W. 11 lks.  
 a 10" Fir Brs. S57°E. 48 lks  
 ● see mon. file, Brass Cap

7. Photo Identification  
 Photo No. EBI 7-54  
 Ident. By: \_\_\_\_\_

5. Investigation Notes: Corner post gone. Found two Fir trees with blazes opened. Sec.-6- B.T. 13", Sec. 1 B.T. 19", no visible scribing on either tree. Dist. and Br. check. Sec. 6 B.T. does not face toward supposed corner. To reach corner from Sec. corner  $\frac{136}{16}$  proceed  $\frac{1}{2}$  mile south.

8. Plane Coordinate Position Data  
 State \_\_\_\_\_ Zone \_\_\_\_\_  
 X \_\_\_\_\_  
 Y \_\_\_\_\_  
 Estab. By \_\_\_\_\_  
 Field Book No. \_\_\_\_\_  
 Where Filed \_\_\_\_\_

9. Evaluation  
 Authentic \_\_\_\_\_  
 Needs Verif. X Monument No  
 Re-estab. Survey  
 Land Status Public Domain

(over)

6. Signed L.B. Brunkow Title Survey Tech. Date 6-1-65

PERPETUATION RECORD

10. Monument:

11. Accessories

Field Book \_\_\_\_\_ Page \_\_\_\_\_

12. Set By \_\_\_\_\_ Title \_\_\_\_\_

13. Recorded By \_\_\_\_\_ Volume \_\_\_\_\_ Page \_\_\_\_\_

(Agency)

License \_\_\_\_\_ Agency \_\_\_\_\_ Date \_\_\_\_\_

(Date) \_\_\_\_\_ (City) \_\_\_\_\_ (County) \_\_\_\_\_ (State) \_\_\_\_\_

14. Remarks:

Blazes <sup>2</sup>  
d ←  
x ← Possible corner

C-25

Index File No. C-1

T 6S R. 30E

Merid. W11

CORNER RECORD (SEARCH)


(Ref. FSM 7151.4)

Tract or Survey No. \_\_\_\_\_ Cor. No. C-1

R.D. Ukiah County Morrow - Umatilla Co. Line

N.F. Umatilla State Oregon

CORNER DIAGRAM

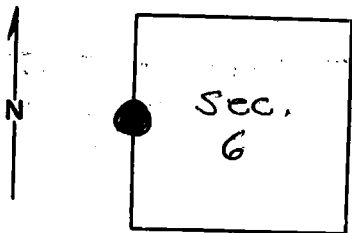

DESCRIBE CORNER MONUMENT FOUND

Brass cap monument,  
See C-25, T6S, R29E, monumentation file.

DESCRIBE BEARING TREES OR OTHER OFFICIAL ACCESSORIES FOUND

PHOTO IDENTIFICATION DATA

Photo No. \_\_\_\_\_

Filed At. \_\_\_\_\_

Object Ident. \_\_\_\_\_

Ident. By \_\_\_\_\_

Signature

PLANE COORDINATE POSITION DATA

State \_\_\_\_\_ Zone \_\_\_\_\_

X \_\_\_\_\_

Y \_\_\_\_\_

Estab. By \_\_\_\_\_

Agency

Signature

*T. Hollaman*

Title

Division

Headquarters

Date

*1/75*

7100-52-(3/68)

6

7

8

2

3

4

5

2

**CORNER RECORD (PERPETUATION)**

**MONUMENT: DESCRIBE NEW MONUMENT SET, OR WORK DONE TO PRESERVE EXISTING MONUMENT**

9

**ACCESSORIES : DESCRIBE NEW BT'S WITNESS OBJECTS ETC. ESTABLISHED, OR WORK DONE TO PRESERVE EXISTING EVIDENCE.**

10

Work Done By \_\_\_\_\_ Title \_\_\_\_\_ Date \_\_\_\_\_ State Registration No. \_\_\_\_\_  
or Agency \_\_\_\_\_

Certified Cor. Record Prepared ? Yes No Filed At: \_\_\_\_\_ Date \_\_\_\_\_ 11

**REMARKS**

12

Index File No. T. R. M. Tract or Surv. No. Cor. 13