

Index  
 File No. C-14  
 T 6S. R. 30E  
 Merid. Willamette


CORNER RECORD (SEARCH)

(Ref. FSM 7151.4)

Tract or  
 Survey No. \_\_\_\_\_ Cor.  
 No. \_\_\_\_\_

R.D. Ukiah County Umatilla  
 N.F. Umatilla State Oregon

CORNER DIAGRAM

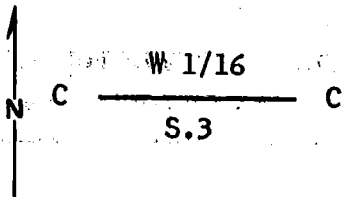

DESCRIBE CORNER MONUMENT FOUND

None  
 Set brass cap

DESCRIBE BEARING TREES OR OTHER OFFICIAL ACCESSORIES FOUND

None

PHOTO IDENTIFICATION DATA

Photo No. \_\_\_\_\_  
 Filed At. \_\_\_\_\_  
 Object Ident. \_\_\_\_\_  
 Ident. By \_\_\_\_\_  
 Signature \_\_\_\_\_

PLANE COORDINATE POSITION DATA

State \_\_\_\_\_ Zone \_\_\_\_\_  
 X \_\_\_\_\_  
 Y \_\_\_\_\_  
 Estab. By \_\_\_\_\_  
 Agency \_\_\_\_\_

DESCRIBE CORNER LOCATION RELATIVE TO NEAR-BY FEATURES, ALSO HOW TO REACH CORNER

From the intersection of U.S. Forest Roads 419N and 537N, go East 3.3 miles, then West about 1.1 miles, then North about 0.7 miles, then walk Northeast 800 ft. to corner.

Signature  
*David H. Kula*

Title Survey Division Umatilla Headquarters  
OPCS 933

Date  
7-77

7100-52-(3/68)

CORNER RECORD (PERPETUATION)

MONUMENT: DESCRIBE NEW MONUMENT SET, OR WORK DONE TO PRESERVE EXISTING MONUMENT

W 1/16

Set 2 1/2" x 30" iron pipe with brass cap

C \_\_\_\_\_ C

Pipe is 24" in ground.

S.3

Mound of stone to cap.

1977

Stamped as shown:

PLS 933

9

ACCESSORIES: DESCRIBE NEW BT'S WITNESS OBJECTS ETC. ESTABLISHED, OR WORK DONE TO PRESERVE EXISTING EVIDENCE

A 8" fir bears N. 75°13' W. 24.3 ft. dist.

A 8" fir bears S. 31°26' W. 37.2 ft. dist.

Set steel fence post 3' East of brass cap w/signs.

Painted red band around bearing trees w/signs.

10

Work Done By: T. Hamby Title Party Chief Date 6/23/77 State Registration No. \_\_\_\_\_ or Agency \_\_\_\_\_

Certified Cor. Record Prepared? Yes  No \_\_\_\_\_ Filed At: \_\_\_\_\_ Date \_\_\_\_\_

11

REMARKS

12

Index File No. T. R. M. Tract or Surv. No. Cor. \_\_\_\_\_

13