

USDA-FOREST SERVICE

Index
File No. C-19


CORNER RECORD (SEARCH)

(Ref. FSM 7151.4)

Tract or
Survey No. _____ No. _____

T 6S. R. 30E. R.D. Ukiah County Umatilla
Merid. Willamette N.F. Umatilla State Oregon

CORNER DIAGRAM

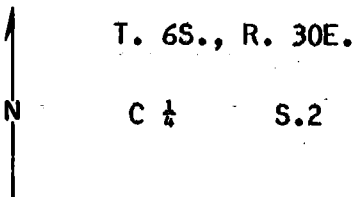

DESCRIBE CORNER MONUMENT FOUND

None
Set brass cap

DESCRIBE BEARING TREES OR OTHER OFFICIAL ACCESSORIES FOUND

None

PHOTO IDENTIFICATION DATA

Photo No. _____
Filed At. _____
Object Ident. _____
Ident. By _____
Signature

DESCRIBE CORNER LOCATION RELATIVE TO NEAR-BY FEATURES, ALSO HOW TO REACH CORNER

From intersection of U.S. Forest Road 419N and 527N,
go East - by South about 2.6 miles, then turn left and go
East 0.4 miles, then walk South 10chns. to corner.

PLANE COORDINATE POSITION DATA

State _____ Zone _____
X _____
Y _____
Estab. By _____
Agency

Signature
David H. Klein

Title _____ Division OPLS Headquarters 933 Date 7-77 7100-52-(3/68)

CORNER RECORD (PERPETUATION)

MONUMENT: DESCRIBE NEW MONUMENT SET, OR WORK DONE TO PRESERVE EXISTING MONUMENT

Set 2½" x 30" iron pipe with brass cap.
Pipe is 25" in ground.

T. 6S., R. 30E.

C ¼ S, 2

Stamped:

1977
PLS 933

9

ACCESSORIES: DESCRIBE NEW BT'S WITNESS OBJECTS ETC. ESTABLISHED, OR WORK DONE TO PRESERVE EXISTING EVIDENCE

A 14" fir bears N. 80° W. 32.3 ft.
A 8" fir bears S. 70° 50' W. 19.5 ft.

Set steel fence post 2 ft. North of corner w/sign.
Painted red band around BT trees w/sign.

10

Work Done By T. Hamby Title Party Chief Date 6/23/77 State Registration No. _____
or Agency _____

Certified Cor. Record Prepared? Yes No _____ Filed At: _____ Date _____ 11

REMARKS

12

Index File No. T. R. M. Tract or Surv. No. Cor. 13