

Index
File No. C-2

CORNER RECORD (SEARCH)

(Ref. FSM 7151.4)

Tract or
Survey No. _____ No. 1/16


T 6S R. 30E

R.D. Ukiah County Umatilla

Merid. Willamette

N.F. Umatilla State Oregon

CORNER DIAGRAM

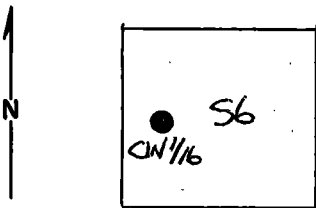

DESCRIBE CORNER MONUMENT FOUND

None

DESCRIBE BEARING TREES OR OTHER OFFICIAL ACCESSORIES FOUND

None

PHOTO IDENTIFICATION DATA

Photo No. _____

Filed At. _____

Object Ident. _____

Ident. By _____

Signature

PLANE COORDINATE POSITION DATA

State _____ Zone _____

X _____

Y _____

Estab. By _____

Agency

Signature

DESCRIBE CORNER LOCATION RELATIVE TO NEAR-BY FEATURES, ALSO HOW TO REACH CORNER

Corner is approximately 550' East of unnumbered North-South Road. Location tag on East side of road.

PLS

346

9/79

Title

Division

Headquarters

Date

CORNER RECORD (PERPETUATION)

MONUMENT: DESCRIBE NEW MONUMENT SET, OR WORK DONE TO PRESERVE EXISTING MONUMENT

Set 32" X 2" flanged iron pipe with brass cap marked:

T6S R30E

W 1/16

C C

S6

1979

PLS 346

9

ACCESSORIES : DESCRIBE NEW BT'S WITNESS OBJECTS ETC. ESTABLISHED, OR WORK DONE TO PRESERVE EXISTING EVIDENCE

White Fir, 7" Dia., BRS. N32°W., 12.2 Ft. Distance.

White Fir, 7" Dia., BRS. S10°W., 14.4 Ft. Distance.

10

Work Done By Wayne O. Harris Title PLS Date 9/79 State Registration No. 346
or Agency

Certified Cor. Record Prepared ? YES ~~NOX~~ Filed At: Umatilla Co. Surveyor Office Date _____

11

REMARKS

Index File No. C-2 T.6S R.30E W.M. Tract or Surv. No.

Cor. CW 1/16
S6

12

13