

**CORNER RECORD (SEARCH)**

(Ref. FSM 7151.4)

Tract or

Survey No. \_\_\_\_\_

No. C<sup>1</sup>/<sub>4</sub> Cor. \_\_\_\_\_

Index  
File No. C-3


T 6S R. 30E

R.D. Ukiah County Umatilla

Merid. Willamette

N.F. Umatilla State Oregon

**CORNER DIAGRAM**

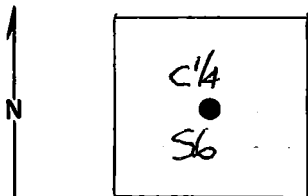

**DESCRIBE CORNER MONUMENT FOUND**

None

**DESCRIBE BEARING TREES OR OTHER OFFICIAL ACCESSORIES FOUND**

None

**PHOTO IDENTIFICATION DATA**

Photo No. \_\_\_\_\_

Filed At. \_\_\_\_\_

Object Ident. \_\_\_\_\_

Ident. By \_\_\_\_\_

*Signature*

**PLANE COORDINATE POSITION DATA**

State \_\_\_\_\_ Zone \_\_\_\_\_

X \_\_\_\_\_

Y \_\_\_\_\_

Estab/By *W. J. H.* Agency \_\_\_\_\_

*Signature*

**DESCRIBE CORNER LOCATION RELATIVE TO NEAR-BY FEATURES, ALSO HOW TO REACH CORNER**

Corner is approximately 500' East of unnumbered North-South Road. Location tag on East side of Road.

Title \_\_\_\_\_

Division \_\_\_\_\_

Headquarters \_\_\_\_\_

Date \_\_\_\_\_

7100-52-(3/68)

## CORNER RECORD (PERPETUATION)

GPO 902-673

MONUMENT: DESCRIBE NEW MONUMENT SET, OR WORK DONE TO PRESERVE EXISTING MONUMENT

Set 32" X 2" flanged iron pipe with brass cap marked:

T6S R30E

C $\frac{1}{4}$  S6

1979

PLS 346

ACCESSORIES: DESCRIBE NEW BT'S WITNESS OBJECTS ETC. ESTABLISHED, OR WORK DONE TO PRESERVE EXISTING EVIDENCE

Ponderosa Pine, 10" Dia., BRS. S65 $\frac{10}{2}$  E, 23.2 Ft. Distance.Douglas Fir, 12" Dia., BRS. N44 $\frac{1}{2}$  W, 49.4 Ft. Distance.

6' Iron Fence Post with "Survey Monument" sign within 5' of Corner.

Work Done By Wayna O. Harris Title PLS Date 9/79 State Registration No. 346  
or AgencyCertified Cor. Record Prepared ? YES XXX Filed At Umatilla Co. Surveyor Office Date

REMARKS

Index File No. C-3 T. 6S R. 30E. W.M.

Tract or Surv. No.

Cor. C $\frac{1}{4}$  S6