

USDA-FOREST SERVICE


Index  
File No. D-14

CORNER RECORD (SEARCH)  
(Ref. FSM 7151.4)

Tract or  
Survey No. \_\_\_\_\_ Cor.  
No. \_\_\_\_\_

T 6S. R. 30E. R.D. Ukiah County Umatilla  
Merid. Willamette N.F. Umatilla State Oregon

CORNER DIAGRAM

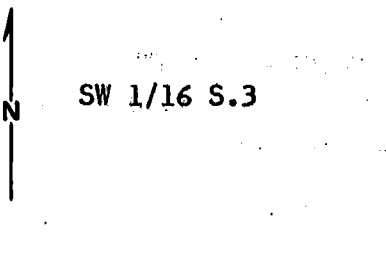

DESCRIBE CORNER MONUMENT FOUND

None  
*Set brass cap*

DESCRIBE BEARING TREES OR OTHER OFFICIAL ACCESSORIES FOUND

None

PHOTO IDENTIFICATION DATA

Photo No. \_\_\_\_\_  
Filed At. \_\_\_\_\_  
Object Ident. \_\_\_\_\_  
Ident. By \_\_\_\_\_  
*Signature*

DESCRIBE CORNER LOCATION RELATIVE TO NEAR-BY FEATURES, ALSO HOW TO REACH CORNER

From the intersection of U.S. Forest Roads 419 and 537, go East 3.3 miles along 537N, then West 1.1 miles, then North 0.7 miles, then walk West about 300 ft. to corner.

PLANE COORDINATE POSITION DATA

State \_\_\_\_\_ Zone \_\_\_\_\_  
X \_\_\_\_\_  
Y \_\_\_\_\_  
Estab. By \_\_\_\_\_  
*Agency*

*Signature* David H. Huber Title \_\_\_\_\_ Division OPLS Headquarters 933 Date 7-77 7100-52-(3/68)

CORNER RECORD (PERPETUATION)

MONUMENT: DESCRIBE NEW MONUMENT SET, OR WORK DONE TO PRESERVE EXISTING MONUMENT

Set 2 1/2" x 30" iron pipe with brass cap.  
Pipe is 15" in ground.  
Mound of stone to cap.

T. 6 S., R. 30E.

SW 1/16 S.3

Stamped as shown:

ACCESSORIES : DESCRIBE NEW BT'S WITNESS OBJECTS ETC. ESTABLISHED, OR WORK DONE TO PRESERVE EXISTING EVIDENCE

A 8" fir bears N. 34°22' W. 29.8 ft.  
A 8" pine bears S. 09°07' W. 34.9 ft.

Set steel fence post 4' East of brass cap w/sign.  
Painted red band around bearing trees w/sign.

Work Done By T. Hamby Title Party Chief Date 6/23/77 State Registration No. \_\_\_\_\_  
or Agency \_\_\_\_\_

Certified Cor. Record Prepared ? Yes  No \_\_\_\_\_ Filed At: \_\_\_\_\_ Date \_\_\_\_\_

REMARKS

Index File No. T. R. M. Tract or Surv. No. Cor. \_\_\_\_\_