

USDA-FOREST SERVICE

Index
File No. E-23

CORNER RECORD (SEARCH)

(Ref. FSM 7151.4)

Tract or
Survey No. _____
Cor. No. 1/4


T 6S R. 30E

R.D. UKIAH County UMATILLA

Merid. WILLAMETTE

N.F. UMATILLA State OR

CORNER DIAGRAM

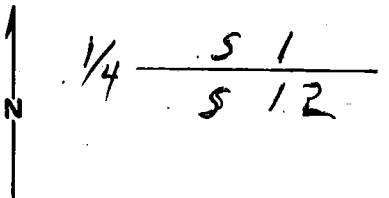

DESCRIBE CORNER MONUMENT FOUND

NONE

DESCRIBE BEARING TREES OR OTHER OFFICIAL ACCESSORIES FOUND

A 24" PINE STUMP BR S 18° E 396 FT MKD BT

PHOTO IDENTIFICATION DATA

Photo No. _____
Filed At. _____
Object Ident. _____
Ident. By _____

Signature

PLANE COORDINATE POSITION DATA

State _____ Zone _____
X _____
Y _____
Estab. By _____
Agency

DESCRIBE CORNER LOCATION RELATIVE TO NEAR-BY FEATURES, ALSO HOW TO REACH CORNER

CORNER IS 10 FT SE OF OLD LOGGING RD.

Signature

R.D. [Signature]

Title

LAND SURVEYOR

Division

Headquarters

Date

9-30-76

7100-52-(3/68)

CORNER RECORD (PERPETUATION)

MONUMENT: DESCRIBE NEW MONUMENT SET, OR WORK DONE TO PRESERVE EXISTING MONUMENT

SET 2 1/2" x 30" IRON PIPE W/ BRASS CAP MKD

T6SR30E

1/4 $\frac{51}{512}$

1976

OPL5598

9

ACCESSORIES : DESCRIBE NEW BT'S WITNESS OBJECTS ETC. ESTABLISHED, OR WORK DONE TO PRESERVE EXISTING EVIDENCE

NEW BTs

A 12" PINE BR5 N49°E 55 FT MKD T6SR30E 1/4 51 BT

A 9" " " S34°E 25 " " T6SR30E 1/4 512 BT

10

Work Done By: R. D. BAGETT Title LAND SURVEYOR Date 9-30-76 State Registration No. OPL5598
or AgencyCertified Cor. Record Prepared? Yes No Filed At: UMATILLA C.S. Date _____ 11

REMARKS

12

Index File No. E23 T. R. M. Tract or Surv. No. Cor. 13