

CORNER RECORD (SEARCH)

(Ref. FSM 7151.4)

Tractor

Survey No. _____

No. $\frac{1}{4}$ Cor.

File No. E-3

T 6S R. 30E.

R.D. Ukiah


County Umatilla

Merid: Willamette

N.F. Umatilla

State Oregon

CORNER DIAGRAM

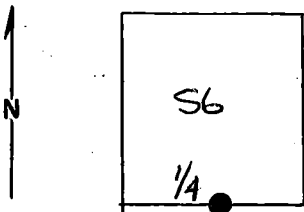

DESCRIBE CORNER MONUMENT FOUND

None

DESCRIBE BEARING TREES OR OTHER OFFICIAL ACCESSORIES FOUND

None (See Remarks)

PHOTO IDENTIFICATION DATA

Photo No. _____

Filed At _____

Object Ident. _____

Ident. By _____

Signature

PLANE COORDINATE POSITION DATA

State _____ Zone _____

X _____

Y _____

Estab. By _____

Agency

Signature

DESCRIBE CORNER LOCATION RELATIVE TO NEAR-BY FEATURES, ALSO HOW TO REACH CORNER

Corner is approximately 200' East of unnumbered North-South Road
Location tag on East side of Road.

Title

PLS
Division

346
Headquarters

9/79
Date

7100-52 (3/69)

CORNER RECORD (PERPETUATION)

MONUMENT: DESCRIBE NEW MONUMENT SET, OR WORK DONE TO PRESERVE EXISTING MONUMENT

Set 32" X 2" Flanged iron pipe with brass cap marked:

T6S R30E
1/4 S6
S7
1979
PLS 346

ACCESSORIES : DESCRIBE NEW BT'S WITNESS OBJECTS ETC. ESTABLISHED, OR WORK DONE TO PRESERVE EXISTING EVIDENCE

Ponderosa Pine, 10" Dia., BRS. N21 1/2° E., 26.5 Ft. Distance.
Douglas Fir, 10" Dia., BRS. S45 1/4° E., 19.7 Ft. Distance.
6' Iron Fence Post with "Survey Monument" sign within 5' of Corner.

Work Done By Wayna O. Harris Title PLS Date 9/79 State Registration No. 346
or Agency

Certified Cor. Record Prepared ? YES XXXX Filed At: Umatilla Co. Surveyor Office Date _____

REMARKS

USDA-FOREST SERVICE

Index

File No. E-3

CORNER RECORD (SEARCH)

(Ref. FSM 7151.4)

Tract or

Survey No. _____

Cor.

No. E-3

T 6S R. 30E

R.D. Ukiah


County Umatilla

Merid. Willamette

N.F. Umatilla

State Oregon

CORNER DIAGRAM

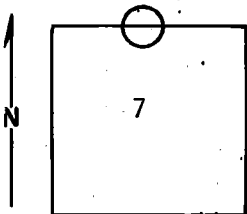

DESCRIBE CORNER MONUMENT FOUND

None

DESCRIBE BEARING TREES OR OTHER OFFICIAL ACCESSORIES FOUND

2 dead fir B.T.s with visible scribing. They are approx. the proper distance apart. However, the scribing does not face the back AZIMUTH of the calls, nor are the trees the proper species. (the calls were both Pine)

PHOTO IDENTIFICATION DATA

Photo No. _____

Filed At. _____

Object Ident. _____

Ident. By _____

Signature

PLANE COORDINATE POSITION DATA

State _____ Zone _____

X _____

Y _____

Estab. By _____

Agency

DESCRIBE CORNER LOCATION RELATIVE TO NEAR-BY FEATURES, ALSO HOW TO REACH CORNER

Signature

T. HOLLAMON

Title

ENG. TECH.

Division

Headquarters

Date

5/12/78

7100-52-(3/68)

CORNER RECORD (PERPETUATION)

MONUMENT: DESCRIBE NEW MONUMENT SET, OR WORK DONE TO PRESERVE EXISTING MONUMENT

9

ACCESSORIES : DESCRIBE NEW BT's WITNESS OBJECTS ETC. ESTABLISHED, OR WORK DONE TO PRESERVE EXISTING EVIDENCE

10

Work Done By _____ Title _____ Date _____ State Registration No. or Agency _____

Certified Cor. Record Prepared ? Yes No Filed At: _____ Date _____

11

REMARKS

12

Index File No. T. R. M. Tract or Surv. No. Cor.

13