

USDA-FOREST SERVICE

Index

File No. E-7

T 6S R. 30E

Merid. Willamette

CORNER RECORD (SEARCH)


(Ref. FSM 7151.4)

R.D. Ukiah County Umatilla

N.F. Umatilla State Oregon

Tract or Survey No. \_\_\_\_\_ Cor. No. 1/4

CORNER DIAGRAM

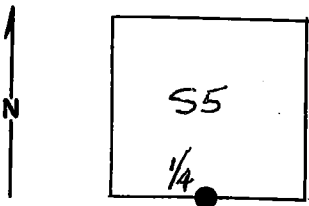

DESCRIBE CORNER MONUMENT FOUND

Found split stone and 2" X 2" squared post (wood)  
(See U.S.F.S. Corner Records, Umatilla National Forest.)

DESCRIBE BEARING TREES OR OTHER OFFICIAL ACCESSORIES FOUND

None (See Remarks)

PHOTO IDENTIFICATION DATA

Photo No. \_\_\_\_\_

Filed At. \_\_\_\_\_

Object Ident. \_\_\_\_\_

Ident. By \_\_\_\_\_

*Signature*

PLANE COORDINATE POSITION DATA

State \_\_\_\_\_ Zone \_\_\_\_\_

X \_\_\_\_\_

Y \_\_\_\_\_

Estab. By \_\_\_\_\_

*Signature*

DESCRIBE CORNER LOCATION RELATIVE TO NEAR-BY FEATURES, ALSO HOW TO REACH CORNER

Corner is approximately 600' East of Road shown on Thompson Flat 7 $\frac{1}{2}$  Min. Quad Map. Location tag on East side of road.

PLS

346

9/79

Title

Division

Headquarters

Date

7100-52-(3/68)

**CORNER RECORD (PERPETUATION)**

**MONUMENT: DESCRIBE NEW MONUMENT SET, OR WORK DONE TO PRESERVE EXISTING MONUMENT**

Set 32" X 2" flanged iron pipe with brass cap marked:

T6S R30E

$\frac{1}{4}$

S5

S8

1979

PLS 346

**ACCESSORIES : DESCRIBE NEW BT'S WITNESS OBJECTS ETC. ESTABLISHED, OR WORK DONE TO PRESERVE EXISTING EVIDENCE**

Douglas Fir, 13" Dia., BRS. N46 $\frac{1}{4}$ <sup>0</sup>E., 16.7 Ft. Distance.

Douglas Fir, 9" Dia., BRS. S45 $\frac{1}{2}$ <sup>0</sup>E., 13.6 Ft. Distance.

6' Iron Fence Post with "Attention" sign within 5' of corner.

10

Work Done By Wayne O. Harris Title PLS Date 9/79 State Registration No. 346  
or Agency

Certified Cor. Record Prepared ? YES ~~NO~~ Filed At: Umatilla Co. Surveyor Office Date

11

**REMARKS**

From Corner

Down Lodgepole Pine, 8" Dia., Root Hole of which BRS S2<sup>0</sup>E., 10.6 Ft. Distance with Heppner Lumber Co. location tag.

Index File No. E-7 T. 6S R. 30E W.M.

Tract or Surv. No.

U.S. G.P.O. 1977-725-576/586  
Cor.  $\frac{1}{4}$  8 13

Index

File No. E-7

**CORNER RECORD (SEARCH)**

(Ref. FSM 7151.4)

Tract or Survey No. \_\_\_\_\_ Cor. No. \_\_\_\_\_


T 6S R. 30E

R.D. Ukiah County \_\_\_\_\_

Merid. Willamette

N.F. Umatilla State Oregon

**CORNER DIAGRAM**

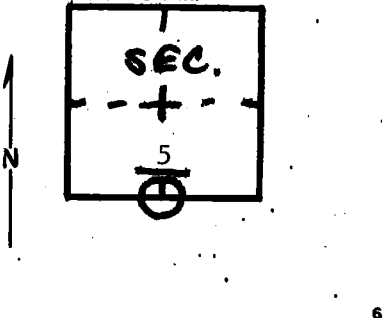

**DESCRIBE CORNER MONUMENT FOUND**

Split Stone

Not original, Probably placed there by Heppner Lmbr. Co. in 1956.

**DESCRIBE BEARING TREES OR OTHER OFFICIAL ACCESSORIES FOUND**

None. A Heppner Lmbr Co. location poster oan a 6" L.P. Pine 10' south of stone. Evidence of stump hole where N.E. B.T. should be and very rotten down L.P. Pine where SW B.T. should be.

**PHOTO IDENTIFICATION DATA**

Photo No. \_\_\_\_\_

Filed At. \_\_\_\_\_

Object Ident. \_\_\_\_\_

Ident. By \_\_\_\_\_

*Signature*

**PLANE COORDINATE POSITION DATA**

State \_\_\_\_\_ Zone \_\_\_\_\_

X \_\_\_\_\_

Y \_\_\_\_\_

Estab. By \_\_\_\_\_

*Agency*

**DESCRIBE CORNER LOCATION RELATIVE TO NEAR-BY FEATURES, ALSO HOW TO REACH CORNER**

Signature

Title

Division

Headquarters

Date

T. HOLLAMAN

ENG. TECH.

5/10/78

7100-52-(3/68)

## CORNER RECORD (PERPETUATION)

---

 MONUMENT: DESCRIBE NEW MONUMENT SET, OR WORK DONE TO PRESERVE EXISTING MONUMENT
 

---

9

---

 ACCESSORIES: DESCRIBE NEW BT'S WITNESS OBJECTS ETC. ESTABLISHED, OR WORK DONE TO PRESERVE EXISTING EVIDENCE
 

---

10

---

 Work Done By \_\_\_\_\_ Title \_\_\_\_\_ Date \_\_\_\_\_ State Registration No.  
 or Agency \_\_\_\_\_
 

---



---

 Certified Cor. Record Prepared? Yes No Filed At: \_\_\_\_\_ Date \_\_\_\_\_ 11
 

---

REMARKS

12

---

 Index File No. T. R. M. Tract or Surv. No. Cor. 13
 

---