

U. S. Department of Agriculture  
FOREST SERVICE

Umofita NATIONAL FOREST

CORNERS OF THE PUBLIC SURVEY

T. 6S R. 30E 14 Mer.

14 Corner common to Sections

9, and 16

Corner consists of a rock mound (not) in place

State condition good

Dimensions above ground 8 inches.

Sketch grooves, letters, figures, or notches, on proper face or edge.

CARDINAL POSITION

DIAGONAL POSITION

Was not				scribed			
N	W	S	E	NW	SW	SE	NE

Mound of \_\_\_\_\_ is located \_\_\_\_\_

Pits are located \_\_\_\_\_

Sketch markings of Bearing Trees (or Rocks) in proper box and fill blanks below, giving bearings from Corner to Trees and Distances in Links.

<u>All</u>	<u>BTS</u>	<u>one</u>	<u>one</u>

Species \_\_\_\_\_

Diameter \_\_\_\_\_

Bearing \_\_\_\_\_

Distance \_\_\_\_\_

Do you believe this to be a genuine Land Office Corner? yes

If not, why? \_\_\_\_\_


4/1/52 (Date)

[Signature] (Signature)

Forester (Title)

T. 65 R. 30 Mer.

(Make sketch of topography near Corner and show section line markers thus "X")

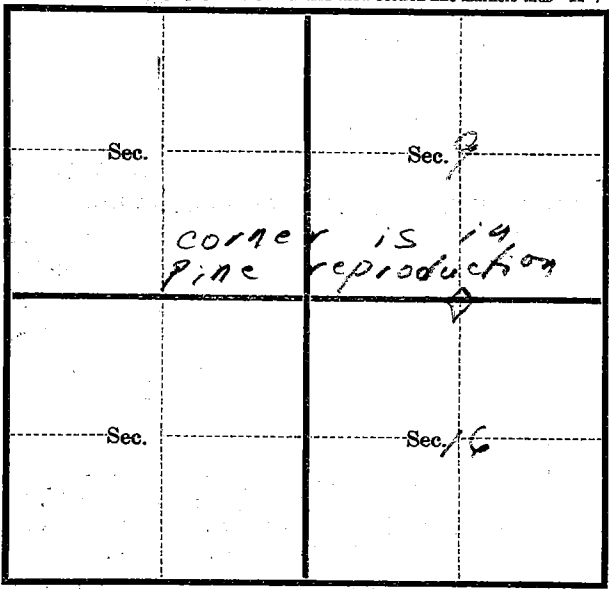

Metal Location Poster is on a Ponderosa pine  
 tree 3 inches diameter, on the North  
 side of the tree from which  
 this Corner bears \_\_\_\_\_ Chains.  
 (Bearing) (Distance)

Section line marker between Secs. \_\_\_\_\_ and \_\_\_\_\_ is on  
 a \_\_\_\_\_ on the \_\_\_\_\_  
 (Tree, post, etc.) (Name of road, trail, etc.)

located \_\_\_\_\_ chains E, W, N, S., from Sec. Cor.; 1/4 Cor.; Witness Cor.  
 (Cross out nonapplicable)

Give any further facts needed to find Corner again:  
 \_\_\_\_\_  
 \_\_\_\_\_  
 \_\_\_\_\_  
 \_\_\_\_\_  
 \_\_\_\_\_

USDA-FOREST SERVICE

Index File No. J-11

CORNER RECORD (SEARCH)


(Ref. FSM 7151.4)

Tract or Survey No. \_\_\_\_\_ Cor. No. \_\_\_\_\_

T 65 R. 30E R.D. \_\_\_\_\_ County \_\_\_\_\_

Merid. Will N.F. \_\_\_\_\_ State OREGON

CORNER DIAGRAM

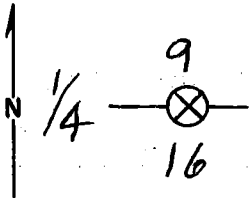

DESCRIBE CORNER MONUMENT FOUND

STONE MOUND - NONE WITH MARKS

DESCRIBE BEARING TREES OR OTHER OFFICIAL ACCESSORIES FOUND

BT'S ARE GONE,

PHOTO IDENTIFICATION DATA

Photo No. \_\_\_\_\_  
 Filed At. \_\_\_\_\_  
 Object Ident. \_\_\_\_\_  
 Ident. By \_\_\_\_\_  
 Signature \_\_\_\_\_

DESCRIBE CORNER LOCATION RELATIVE TO NEAR-BY FEATURES, ALSO HOW TO REACH CORNER

K tag on a 3" PONDEROSA PINE ON NORTH SIDE OF TREE.

PLANE COORDINATE POSITION DATA

State \_\_\_\_\_ Zone \_\_\_\_\_  
 X \_\_\_\_\_  
 Y \_\_\_\_\_  
 Estab. By \_\_\_\_\_  
 Agency \_\_\_\_\_

Signature A.G. OARD

Title \_\_\_\_\_ Division FORESTER Headquarters \_\_\_\_\_ Date 4/11/52

**CORNER RECORD (PERPETUATION)**

**MONUMENT: DESCRIBE NEW MONUMENT SET, OR WORK DONE TO PRESERVE EXISTING MONUMENT**

**ACCESSORIES : DESCRIBE NEW BT'S WITNESS OBJECTS ETC. ESTABLISHED, OR WORK DONE TO PRESERVE EXISTING EVIDENCE**

Work Done By \_\_\_\_\_ Title \_\_\_\_\_ Date \_\_\_\_\_ State Registration No. \_\_\_\_\_  
or Agency \_\_\_\_\_

Certified Cor. Record Prepared ? Yes No Filed At: \_\_\_\_\_ Date \_\_\_\_\_

**REMARKS**

Index File No. T. R. M. Tract or Surv. No. Cor.