

Index File No. Z-25

CORNER RECORD (SEARCH)

(Ref. FSM 7151.4)

Tract or Survey No. _____

Cor. No. _____

T 6S R. 29E

R.D. NORTH FORK JOHN DAY County GRANT / MORROW / UMATILLA

Merid. WILLAMETTE

N.F. UMATILLA State OREGON

CORNER DIAGRAM

DESCRIBE CORNER MONUMENT FOUND

MOUND OF STONES A FEW FEET DOWN SLOPE FROM CORNER POINT AS DETERMINED BY REFERENCE TO THE BEARING TREE. ONE STONE MAY HAVE 2 GROOVES ON ONE FACE.

DESCRIBE BEARING TREES OR OTHER OFFICIAL ACCESSORIES FOUND

ALL STONES ARE SMALLER THAN RECORD. ORIGINAL 18" JUNIPER IS LIVE WITH SCRIBES, "R30E T7S 56 BT", VISIBLE ON DOUBLE, UNHEALED BLAZES WITH CHAINING NOTCH. BEARS S18°E, 37 LINKS.

DESCRIBE CORNER LOCATION RELATIVE TO NEAR-BY FEATURES, ALSO HOW TO REACH CORNER

POSITION DETERMINED WITH A "PLGR" GPS RECEIVER (NAD '83): N 44-59-45.80 (±14M) W 119-09-47.81

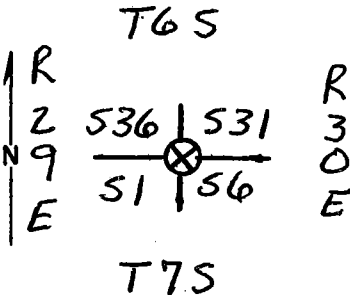


PHOTO IDENTIFICATION DATA

Photo No. _____
Filed At. _____
Object Ident. _____
Ident. By _____
Signature _____

PLANE COORDINATE POSITION DATA

State _____ Zone _____
X _____
Y _____
Estab. By _____
Agency _____

Signature

Title

Division

Headquarters

Date

FS-7100-52 (3/68)

Dennis L. Laylord PLS 1636

8/20/1997

CORNER RECORD (PERPETUATION)

MONUMENT : DESCRIBE NEW MONUMENT SET, OR WORK DONE TO PRESERVE EXISTING MONUMENT

9

ACCESSORIES : DESCRIBE NEW BT'S WITNESS OBJECTS ETC. ESTABLISHED, OR WORK DONE TO PRESERVE EXISTING EVIDENCE

10

Work Done By _____ Title _____ Date _____ State Registration No. or Agency _____

Certified Cor. Record Prepared ? Yes No Filed At: _____ Date _____

11

REMARKS

12

Index File No. T. R. M. S. Tract or Surv. No. Cor. 13