

CORNER RECORD (SEARCH)

(Ref. FSM 7151.4)

Tract or

Survey No. _____

No. _____

Index

File No. L-5


T 6S R. 31E

R.D. Ukiah County _____

Merid. Willamette

N.F. Umatilla State Oregon

CORNER DIAGRAM

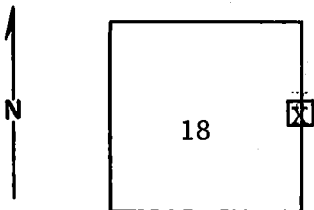

DESCRIBE CORNER MONUMENT FOUND

Basalt stone. 12x12x10

no visable markings, no mound

DESCRIBE BEARING TREES OR OTHER OFFICIAL ACCESSORIES FOUND

16" P-Pine - N33W - 16'dist. Blazed: scribed: 4S (lower blaze closed.) 1/4 corner is 130' west of N-S fence (south side of creek).

PHOTO IDENTIFICATION DATA

Photo No. _____

Filed At. _____

Object Ident. _____

Ident. By _____

Signature

PLANE COORDINATE POSITION DATA

State _____ Zone _____

X _____

Y _____

Estab. By. _____

Agency

Signature
Moore, Bill

Title
Eng. Tech.

Division

Headquarters

Date

5/78

7100-52-(3/68)

CORNER RECORD (PERPETUATION)

 MONUMENT: DESCRIBE NEW MONUMENT SET, OR WORK DONE TO PRESERVE EXISTING MONUMENT

9

 ACCESSORIES : DESCRIBE NEW BT'S WITNESS OBJECTS ETC. ESTABLISHED, OR WORK DONE TO PRESERVE EXISTING EVIDENCE

I placed Attention: bearing tree, posters on the bearing tree.

10

 Work Done By _____ Title _____ Date _____ State Registration No. or Agency _____

 Certified Cor. Record Prepared ? Yes No Filed At: _____ Date _____

11

REMARKS

12

 Index File No. T. R. M. Tract or Surv. No. Cor.

13