

USDA-FOREST SERVICE

Index
File No. P-09

CORNER RECORD (SEARCH)

(Ref. FSM 7151.4)

Tract or
Survey No. _____

Cor.
No. _____


T 6 S R. 31 E

R.D. NFJD County Umatilla

Merid. W.M.

N.F. Umatilla State Or.

CORNER DIAGRAM

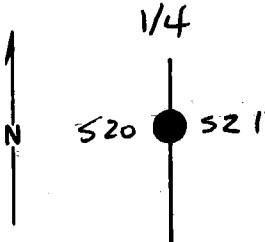

DESCRIBE CORNER MONUMENT FOUND

Found a stone 12" x 12" x 10" with chisled "4" lying on ground tied to an old fence.

DESCRIBE BEARING TREES OR OTHER OFFICIAL ACCESSORIES FOUND

None

PHOTO IDENTIFICATION DATA

Photo No. _____
Filed At. _____
Object Ident. _____
Ident. By _____

Signature _____

PLANE COORDINATE POSITION DATA

State Or. Zone North
X 2618010.295 meters
Y 152890.638 meters
Estab. By NAD 83 (1991)

Agency _____

Signature

Dave Schlarb

Title

Lead Surveyor

Division

Headquarters

S.O.

Date

9/94

FS-7100-52 (3/68)

CORNER RECORD (PERPETUATION)

MONUMENT: DESCRIBE NEW MONUMENT SET, OR WORK DONE TO PRESERVE EXISTING MONUMENT

Could not determine original location of found stone so set by proportion a 2 1/2" by 30" aluminum pipe, with 3/4" aluminum cap, 26" into the ground and raised a mound of stone 2 feet in diameter by 1 foot high.

T6S R31E
V4
S20/S21
PLS 1636
1994

ACCESSORIES: DESCRIBE NEW BT'S WITNESS OBJECTS ETC. ESTABLISHED, OR WORK DONE TO PRESERVE EXISTING EVIDENCE

20" Ponderson Pine N53 3/4 E 12.7 feet mkd "1/4 521" "BT"
 19" Ponderson Pine S49 3/4 E 37.9 feet mkd "1/4 521" "BT"
 18" Ponderson Pine S53 W 30.7 feet mkd "V4 S 20" "BT"
 Buckhorn No. 2, 3/4" aluminum cap, N78°15'W, 66.68 Feet mkd
 "GPS BUCKHORN NO2 1994"

Work Done By D. Gaylord Title Land Surveyor Date 9/94 State Registration No. PLS 1636
 or Agency

Certified Cor. Record Prepared? Yes No Filed At: Umatilla Co. Date

REMARKS

USDA-FOREST SERVICE


Index File No. P-9
 T 6S R. 31E
 Merid. Will.

CORNER RECORD (SEARCH)

(Ref. FSM 7151.4)

Tract or Survey No. _____ No. P-9
 R.D. Ukiah County Umatilla
 N.F. Umatilla State Oregon

CORNER DIAGRAM

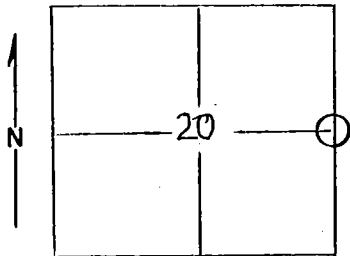

DESCRIBE CORNER MONUMENT FOUND

None

DESCRIBE BEARING TREES OR OTHER OFFICIAL ACCESSORIES FOUND

None could be found. There is a pile of stones in an old Rock Crib possibly containing the corner stone.
 Did nothing here.

PHOTO IDENTIFICATION DATA

Photo No. _____
 Filed At. _____
 Object Ident. _____
 Ident. By _____
Signature

PLANE COORDINATE POSITION DATA

State _____ Zone _____
 X _____
 Y _____
 Estob. By _____
Agency

Signature
 MLC

Title
 For, Tech

Division
 USFS

Headquarters
 Ukiah

Date
 4/19/78

7100-52-(3, 68)