

Index

File No. A-11

CORNER RECORD (SEARCH)

(Ref. FSM 7151.4)

Tract or


Survey No. _____

Cor.

No. _____

T 7S R. 31ER.D. DALECounty GRANTMerid. WILLAMETTEN.F. UMATILLAState OREGON

CORNER DIAGRAM

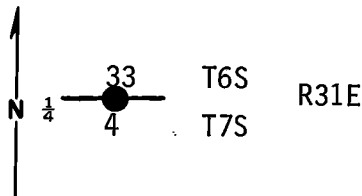

DESCRIBE CORNER MONUMENT FOUND

Found a basalt stone, 24"x14"x3" with faint illegible chisel marks, lying loose on top of a mound of stone 4 ft. diam. and 6" high. We accept the center of the stone mound as the original corner point.

DESCRIBE BEARING TREES OR OTHER OFFICIAL ACCESSORIES FOUND

PHOTO IDENTIFICATION DATA

Photo No. 380-33Filed At. UMATILLA N.F.Object Ident. SUB. STA.Ident. By Gary J. Langley
Forester

PLANE COORDINATE POSITION DATA

State _____ Zone _____

X _____

Y _____

Estab. By _____

Agency

DESCRIBE CORNER LOCATION RELATIVE TO NEAR-BY FEATURES, ALSO HOW TO REACH CORNER

E - W fenceline bears North 112 ft. from corner.

Gary J. Langley (Signature)

Title
P.L.S.

Division

Headquarters

Date

12-14-82

7100-52 (3. 68)

CORNER RECORD (PERPETUATION)

MONUMENT: DESCRIBE NEW MONUMENT SET, OR WORK DONE TO PRESERVE EXISTING MONUMENT

At the corner point as previously described, we set a 2"x30" Galvanized Iron Pipe, 22" in the ground to bedrock with orig. corner stone buried alongside, and supported in a mound of stone 5 ft. dia. at base to ca, with brass cap attached, marked:

T6S
 $\frac{1}{4}$ ~~S33~~ R
 S4 31
 T7S E
 PLS 1099
 1982

ACCESSORIES : DESCRIBE NEW BT'S WITNESS OBJECTS ETC. ESTABLISHED, OR WORK DONE TO PRESERVE EXISTING EVIDENCE

From which we mark new BT's:

A 12" Douglas Fir, scribed " $\frac{1}{4}$ S33 BT" on a double blaze bears N43°W 45.0 ft.

And a 12" Ponderosa Pine, scribed " $\frac{1}{4}$ S4 BT" on a double blaze bears S30°W 117.9 ft.

Brass washer marked "LS 1099" nailed to lower blaze of new BT's.

Work Done By Gary Langlitz Title Land Surveyor Date 8/19/82 State Registration No. LS 1099
 or Agency

Certified Cor. Record Prepared? Yes No Filed At: GRANT AND UMATILLA COUNTY Date 12-82

REMARKS

Corner location established and perpetuated in accordance with our contract, 1979, USFS Cadastral Survey Specifications and 1973 BLM Survey Manual.

Staff Compass and Steel Chain. August 19, 1982
 Declination = 18½°E

Witnesses: Gary Langlitz
 Greg Orton
 Jeff Anderson

Index File No. A-11 T. 75 R. 31E M. WILLAMETTE Tract or Surv. No. Cor.

USDA-FOREST SERVICE

Index
File No. A-11


CORNER RECORD (SEARCH)

(Ref. FSM 7151.4)

Tract or
Survey No. _____ Cor.
No. A-11

T 7S R. 31E R.D. Dale County Grant
Merid. Willamette N.F. Umatilla State Oregon

CORNER DIAGRAM

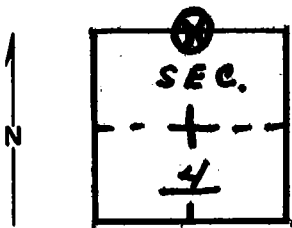

DESCRIBE CORNER MONUMENT FOUND

Material: Stone in mound of stone. Size: 24"x14"x3"
Height Above Ground: 1 foot. Condition: Good.
Markings: No visible marks. Stone mound is about 4' diameter.

2

DESCRIBE BEARING TREES OR OTHER OFFICIAL ACCESSORIES FOUND

None. No BTs originally established.

PHOTO IDENTIFICATION DATA

Photo No. _____
Filed At. _____
Object Ident. _____
Ident. By _____
Signature

6

BLM reject 5/80

3

PLANE COORDINATE POSITION DATA

State _____ Zone _____
X _____
Y _____
Estab. By _____
Agency

7

DESCRIBE CORNER LOCATION RELATIVE TO NEAR-BY FEATURES, ALSO HOW TO REACH CORNER

There is an east-west blazed line from 1/4 corner. There is fence running approx. east-west. The fence is about 60' north of blazed line at corner location. Area has been logged on north side of blazed line. There is a 30" P. pine 15' due east of corner. There is a 28" P. pine in east-west fence line (approx. 60' north of corner). From this tree there are remnants of an old fence running north. Corner location is on a moderate east facing slope

8

Signature T. Hollamon Title Eng. Tech Division Headquarters 3/22/78 Date 7100-52-13/69 cover

CORNER RECORD (PERPETUATION)

 MONUMENT: DESCRIBE NEW MONUMENT SET, OR WORK DONE TO PRESERVE EXISTING MONUMENT

#3 Continued

From a point approx. 100' east of corner the slope breaks steeply to Haden Creek.

 ACCESSORIES : DESCRIBE NEW BT'S WITNESS OBJECTS ETC. ESTABLISHED, OR WORK DONE TO PRESERVE EXISTING EVIDENCE
 9

Work Done By _____	Title _____	Date _____	State Registration No. or Agency _____	10
Certified Cor. Record Prepared ?	Yes No	Filed At _____	Date _____	11

REMARKS

Index File No.	T.	R.	M.	Tract or Surv. No.	Cor.	12
----------------	----	----	----	--------------------	------	----