

USDA-FOREST SERVICE

Index
File No. A-17

CORNER RECORD (SEARCH)

(Ref. FSM 7151.4)

Tract or
Survey No. _____ Cor.
No. _____


T 7S R. 31E

R.D. DALE County GRANT

Merid. WILLAMETTE

N.F. UMATILLA State OREGON

CORNER DIAGRAM

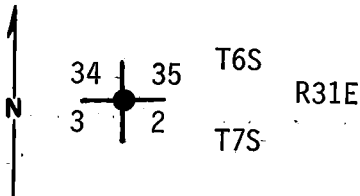

DESCRIBE CORNER MONUMENT FOUND

The probable original monument, a basalt stone, 24"x12"x6" with 4 grooves on a face and 6 grooves on an edge, lying loose, approx. 10 ft. NW of corner point.

DESCRIBE BEARING TREES OR OTHER OFFICIAL ACCESSORIES FOUND

And the only original bearing tree, a 14" Ponderosa Pine, alive and in good condition with scribing visible on a previously opened blaze.

PHOTO IDENTIFICATION DATA

Photo No. 380-14
Filed At. UMATILLA N.F.
Object Ident. DIRECT
Ident. By Ray J. Smith
Substrate

DESCRIBE CORNER LOCATION RELATIVE TO NEAR-BY FEATURES, ALSO HOW TO REACH CORNER

PLANE COORDINATE POSITION DATA

State _____ Zone _____
X _____
Y _____
Estob. By _____
Agency

Ray J. Smith
Signature

Title
P.L.S.

Division

Headquarters

Date
12-14-82

7100-52-(3.68)

USDA-FOREST SERVICE

Index File No. A-17

T 7S R. 31E

Merid. WILL

CORNER RECORD (SEARCH)

(Ref. FSM 7151.4)

R.D. DALE


N.F. UMATILLA

Tract or Survey No. _____ Cor. No. _____

County GRANT-UMATILLA CO. LINE

State ORE

CORNER DIAGRAM

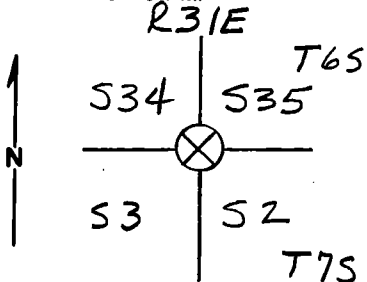

DESCRIBE CORNER MONUMENT FOUND

ORIGINAL CORNER STONE, MARKED WITH 4 GROOVES ON ONE FACE, IS OUT OF POSITION, HAVING SLID DOWN HILL 8-10 FT.

DESCRIBE BEARING TREES OR OTHER OFFICIAL ACCESSORIES FOUND

ONLY ORIGINAL B.T., A 9" PINE, IS NOW A 13" P. PINE WITH A SINGLE HEALED BLAZE FAINTLY VISIBLE. I OPEN & FIND SCRIBING & REVERSE.

DESCRIBE CORNER LOCATION RELATIVE TO NEAR-BY FEATURES, ALSO HOW TO REACH CORNER

CORNER IS 250 FT. ± NORTH OF AN EAST-WEST FENCE LINE, AN OLD NAT'L FOREST BDRY. SIGN IS ON A 36" FIR ON A SMALL RIDGE TOP N50°E, 200 FT. ±.

PHOTO IDENTIFICATION DATA

Photo No. _____

Filed At. _____

Object Ident. _____

Ident. By _____

Signature

PLANE COORDINATE POSITION DATA

State _____ Zone _____

X _____

Y _____

Estab. By _____

Agency

Signature

Title

Division

Headquarters

Date

7100-52-(3/68)

Dennis S. Gaylord

PLS

1636

11/20/80

CORNER RECORD (PERPETUATION)

MONUMENT : DESCRIBE NEW MONUMENT SET, OR WORK DONE TO PRESERVE EXISTING MONUMENT

9

ACCESSORIES : DESCRIBE NEW BT'S WITNESS OBJECTS ETC. ESTABLISHED, OR WORK DONE TO PRESERVE EXISTING EVIDENCE

10

Work Done By _____ Title _____ Date _____ State Registration No. or Agency _____

Certified Cor. Record Prepared ? Yes No Filed At: _____ Date _____

11

REMARKS

12

Index File No. T. R. M. Tract or Surv. No. Cor.

13