

USDA-FOREST SERVICE

Index

File No. A-7

CORNER RECORD (SEARCH)

(Ref. FSM 7151.4)

Tract or
Survey No. _____

Cor.
No. _____


T 7S R. 31E

R.D. DALE County GRANT

Merid. WILLAMETTE

N.F. UMATILLA State OREGON

CORNER DIAGRAM

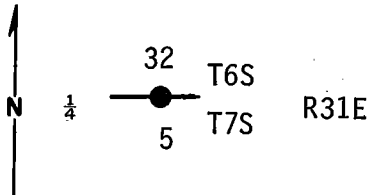

DESCRIBE CORNER MONUMENT FOUND

None.

DESCRIBE BEARING TREES OR OTHER OFFICIAL ACCESSORIES FOUND

None.

PHOTO IDENTIFICATION DATA

Photo No. 380-62

Filed At. UMATILLA N.F.

Object Ident. SUB STA.

Ident. By Gary J. Douglas
Signature

DESCRIBE CORNER LOCATION RELATIVE TO NEAR-BY FEATURES, ALSO HOW TO REACH CORNER

Corner located on a West slope approx. 50 ft. South of an E - W fence.

PLANE COORDINATE POSITION DATA

State _____ Zone _____

X _____

Y _____

Estab. By _____

Signature
Agency

Title
P.L.S.

Division

Headquarters

Date
12-14-82

7100-52 (3. 68)

CORNER RECORD (PERPETUATION)

MONUMENT: DESCRIBE NEW MONUMENT SET, OR WORK DONE TO PRESERVE EXISTING MONUMENT

Corner point determined by survey and single proportionate measurement between the NW corner of Sec. 5 and the NE corner of Sec. 5, T7S R31E, as previously established during this survey, said location agreeing with original topographic calls. At the corner point we set a 2"x30" Galvanized Iron Pipe 14" in the ground to bedrock and supported in a mound of stone 8' dia. to the top of the

T6S
R
S32 31
S5 E
T7S
PLS 1099
1982

ACCESSORIES: DESCRIBE NEW BT'S WITNESS OBJECTS ETC. ESTABLISHED, OR WORK DONE TO PRESERVE EXISTING EVIDENCE
pipe with brass cap attached, marked:

From which we mark the following accessories: A 12" Juniper, scribed "¼ S32 BT" on a double blaze, bears N77° E 61.9 ft., And an "+B0" chiseled 2 ft. above ground on a vertical bedrock face (outcrop measures 6'x3'x4' high) bears S44°E 107.7 ft. Attached brass washer to lower blaze of new BT.

Work Done By Gary Langlitz Title Land Surveyor Date 8/19/82 State Registration No. LS 1099
or Agency

Certified Cor. Record Prepared? Yes No Filed At: GRANT AND UMATILLA COUNTY Date 12-82

REMARKS

Corner location established and perpetuated in accordance with our survey contract.
Magnetic Compass (Declination 18½° East)
Steel Tape

Witnesses: Gary Langlitz
 Greg. Orton
 Jeff Anderson

Index File No. A-7 T. 7S R. 31E M. WILLAMETTE Tract or Surv. No.

Cor.

USDA-FOREST SERVICE

Index
File No. A-7

CORNER RECORD (SEARCH)


(Ref. FSM 7151.4)

Tract or
Survey No. _____ Cor. No. A-7

T 7S R. 31E R.D. Dale County Grant

Merid. Willamette N.F. Umatilla State Oregon

CORNER DIAGRAM

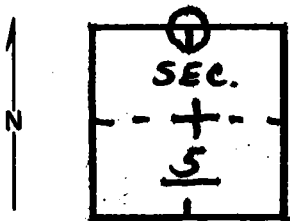

DESCRIBE CORNER MONUMENT FOUND

None.

DESCRIBE BEARING TREES OR OTHER OFFICIAL ACCESSORIES FOUND

None. No BTs were originally established.

PHOTO IDENTIFICATION DATA

Photo No. _____

Filed At. _____

Object Ident. _____

Ident. By _____

Signature

PLANE COORDINATE POSITION DATA

State _____ Zone _____

X _____

Y _____

Estab. By _____

Agency

DESCRIBE CORNER LOCATION RELATIVE TO NEAR-BY FEATURES, ALSO HOW TO REACH CORNER

Area is on steep, rocky west slope which is heavy with underbrush. Chance of finding a 100 year old mound with no accessories is remote. Original call placed the 1/4 corner 165' east of ravine. A fence runs approx. east-west about 100' so. of where corner should be. Fence continues west across ravine.

T. Hollamon, Eng. Tech.

3/22/78

Signature

Title

Division

Headquarters

Date

7100-52 (3/68)

CORNER RECORD (PERPETUATION)

GPO 902-673

MONUMENT: DESCRIBE NEW MONUMENT SET, OR WORK DONE TO PRESERVE EXISTING MONUMENT

9

ACCESSORIES : DESCRIBE NEW BT'S WITNESS OBJECTS ETC. ESTABLISHED, OR WORK DONE TO PRESERVE EXISTING EVIDENCE

10

Work Done By _____ Title _____ Date _____ State Registration No. or Agency _____

Certified Cor. Record Prepared ? Yes No Filed At: _____ Date _____

11

REMARKS

12

Index File No. T. R. M. Tract or Surv. No. Cor. 13