


CERTIFIED RECORD OF LAND CORNER MONUMENTATION

A-9

History of original corner establishment:

ESTABLISHED IN 1884 BY FRANK W. CAMPBELL:

Set a basalt stone 10 inches by 8 inches by 8 inches, 7 inches in the ground for closing corner for Sections 4 and 5 marked. "CC"

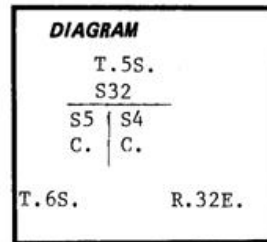

With 4 notches on the east and 2 notches on the west edges from which:

- A 24" tamarack bears S. 37⁰E., 16 links (10.6 ft.) scribed T.6S., R.32E., S.4 BT
- A 30" tamarack bears S. 80⁰W., 29 links (19.1 ft.) scribed T.6S., R.32E., S.5 BT

Description of corner evidence found:

At the corner point, I find a charred, sharpened post 2 feet into the ground.

From which the remains of the original BTs:

- A stump bears S. 45⁰E., 16 links (10.6 ft.) with scribes "BT" visible on an open blaze.
- A stump bears S. 82⁰W., 29 links (19.1 ft.) with scribes "BT" visible on an open blaze.

Description of monument and accessories established to perpetuate the original location of this corner:

At the corner point: Set a 2½" x 30" iron pipe, 20" into the ground in a mound of stones, with a 3" brass cap marked:


T. 5S. R. 32E.

From which:

- A 10" fir bears S. 13⁰E., 112 links (73.9 ft.) scribed T.6S., R.32E., S.4 CC BT.
- A 16" fir bears S. 40⁰W., 137 links (90.4 ft.) scribed T.6S., R.32E., S.5 CC BT.

S32
S5 | S4
C. | C.

T. 6S. R. 32E.
LS 1636
1982

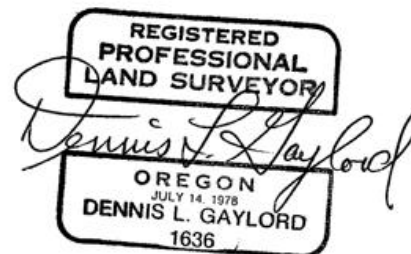

I hereby certify the above corner was perpetuated as hereon described in July 1982. Witness: Scott McMullin

Office of COUNTY SURVEYOR County of UMATILLA
 State of OREGON, I hereby certify that the within instrument was filed in this office
 for record on the 11 day of August, 1982
David H. Klein by _____
 (COUNTY OFFICIAL) (DEPUTY)

Form R6-7100-57 (9/71)

RECEIVED BY ^{A-9}
 Umatilla County Surveyor
 Date 8-82 ★ GPO—790-276
 Rec'd By BL5
 No. 82-102-R