

USDA-FOREST SERVICE

Index
File No. R-18


CORNER RECORD (SEARCH)
(Ref. FSM 7151.4)

Tract or
Survey No. _____
Cor.
No. _____

T 68 R. 32E
Merid. W.M.

R.D. N. Fk. J. Day County Umatilla
N.F. Umatilla State Or.

CORNER DIAGRAM

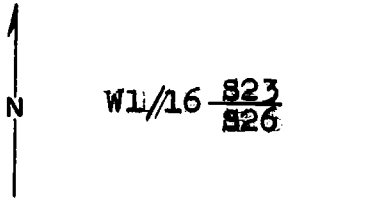

DESCRIBE CORNER MONUMENT FOUND

2 1/2" iron pipe with brass cap mkd. W1/16 823
826
1968

DESCRIBE BEARING TREES OR OTHER OFFICIAL ACCESSORIES FOUND

D. Fir, 22", N54°W, 17.2', with scribing visible
D. Fir, 14", S22°E, 16.5', with healed blaze

PHOTO IDENTIFICATION DATA

Photo No. _____
Filed At. _____
Object Ident. _____
Ident. By _____
Signature

DESCRIBE CORNER LOCATION RELATIVE TO NEAR-BY FEATURES, ALSO HOW TO REACH CORNER

Corner falls on N. slope. From K tag on 076 rd.
follow posted line 1004' west.

PLANE COORDINATE POSITION DATA

State _____ Zone _____
X _____
Y _____
Estab. By _____
Agency

Signature
F. J. Munro

Title L.S. Division _____ Headquarters _____

Date 11/19/86 FS-7100-52 (3/68)

CORNER RECORD (PERPETUATION)

MONUMENT: DESCRIBE NEW MONUMENT SET, OR WORK DONE TO PRESERVE EXISTING MONUMENT

None.

ACCESSORIES : DESCRIBE NEW BT'S WITNESS OBJECTS ETC. ESTABLISHED, OR WORK DONE TO PRESERVE EXISTING EVIDENCE

BTs have blaze and 6" hand painted red, BT tags and "Land Survey Monument" signs. 6' steel fence post with "Land Survey Monument" sign within 5' of the corner.

Work Done By F.S. Munro Title L.S. Date 11/1/86 State Registration No. 1832
or Agency
Certified Cor. Record Prepared ? Yes No Filed At: _____ Date _____

REMARKS

Index File No. R-18 T. 6S R. 32E M. W.M. Tract or Surv. No. _____ Cor. _____