

USDA-FOREST SERVICE

INDEX

FILE NO. 7-7 CORNER RECORD (SEARCH) (Ref. FSM 7151.4) Tract or Survey No. _____ Cor. No. _____
 T. 6 S R. 32 E R.D. North Fork John Day County Umatilla
 Merid. Willanette N.F. UMATILLA State Oregon 1

CORNER DIAGRAM 1 1 DESCRIBE CORNER MONUMENT FOUND
 1 BLM BC 1 1 A standard BLM monument stamped as shown in the diagram.
 1 1/4---- 1
 N 55 1
 1 775 1
 1 1968 1 DESCRIBE BEARING TREES OR OTHER OFFICIAL ACCESSORIES FOUND

----- 1 A 36" dbh Ponderosa Pine bears S44 1/4°E, 13.9' with healed blaze.
 PHOTO IDENTIFICATION DATA 1 A 17" Douglas Fir bears N33°E, 24.4' with visible scribe.
 Photo No. _____ 1 A dead and down 26" dbh Western Larch bears N60°E, 16.5' with visible scribe.
 Filed at. _____ 1 A 13" dbh Douglas Fir bears S76 1/4°W, 37.6' with healed blaze.
 Object Ident. _____ 1
 Ident. By _____ 1
 Signature _____ 1

----- 1
 PLANE COORDINATE POSITION DATA 1 DESCRIBE CORNER LOCATION RELATIVE TO NEAR-BY FEATURES, ALSO HOW TO REACH CORNER
 State _____ Zone _____ 1 From Highway 395, follow FSR 55 6.5 miles to FSR 5505. Follow FSR 5505 0.5 mile to
 X _____ 1 FSR5505020. Then follow FSR5505020 1.1 mile to a junction. Go right 0.25 mile to a junction.
 Y _____ 1 Go right 0.3 mile to a junction. Go left 0.4 mile to a junction. Go left 0.75 mile to a
 Estab. By _____ 1 junction. Go right and follow the road staying right 0.7 mile to the corner of sections
 Agency _____ 1 4, 5, 32 and 33. Follow the sec. line west 0.5 mile to the corner.

----- 1
 Signature Daniel L. Haddock Title Surveyor Division _____ Headquarters Pendleton, OR Date 6-02-94 FS-7100-52 (3/68) 5

CORNER RECORD (PERPETUATION)

MONUMENT : DESCRIBE NEW MONUMENT SET, OR WORK DONE TO PRESERVE EXISTING MONUMENT

Cleared brush and debris away from corner.

9

ACCESSORIES : DESCRIBE NEW BT'S WITNESS OBJECTS ETC. ESTABLISHED, OR WORK DONE TO PRESERVE EXISTING EVIDENCE

Set new bearing tree.

A 10" dbh Douglas Fir bears N9 3/4"W, 26.0' scribed 1/4 S32 BT.

An aluminum washer stamped RLS 852 is nailed between the letters B and T on each new tree. BT and LSM signs are attached to each bearing tree and 6" red bands painted around them.

10

Work Done By David L. Haddock Title Land Surveyor Date 5-27-94 State Registration No. _____
Certified Cor. Record Prepared? x Yes No Filed At: Grant County Surveyor Date 6-94 PLS 852 11

REMARKS

12

Index File No. 7-7 T. 6 S. R. 32 E. M. Willamette Tract or Surv. No. _____ Cor. _____

13

GPD : 1984 0 - 439-095

USDA-FOREST SERVICE

Index
File No. 2-7
T 6S R. 32E
Merid. Willamette


CORNER RECORD (SEARCH)

(Ref. FSM 7151.4)

Tract or
Survey No. _____
Cor.
No. _____

R.D. NORTH FORK JOHN DAY County UMATILLA
N.F. UMATILLA State OREGON

CORNER DIAGRAM

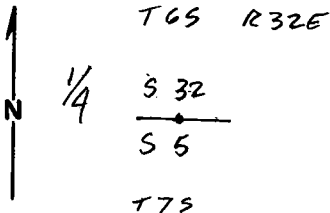

DESCRIBE CORNER MONUMENT FOUND

BRASS CAP MKD. T 6S R 32E, set on iron post in mound of stone.
1/4 S 32
S 5
T 7 S
1968

DESCRIBE BEARING TREES OR OTHER OFFICIAL ACCESSORIES FOUND

A Fir, 15" diam., bears S. 74° W., 57 lbs. or 37.6 ft. dist., healed blaze
A pine, 44" diam., bears S. 43° 30' E., 21 lbs. or 13.9 ft. dist., (record S 43° E),
with healed blaze and a 9" Y scathed on tree.

A Fir, 20" diam., bears N. 34° 30' E., 37 lbs or 30 ft. dist., healed blaze
Steel guard post set 4 ft. EAST of cor. with USFS signs 54-2 & 54-9

DESCRIBE CORNER LOCATION RELATIVE TO NEAR-BY FEATURES, ALSO HOW TO REACH CORNER

cor sets on flat at base of ridge running NW to SE. where logging road
in S. 1/2 of sec. 32 turns to the EAST, 90 SW approx. 1000 ft. ascending
NW to SE hillside. first 600' ft. Continue in SW direction across
flat final 400' through light timber to corner.

PHOTO IDENTIFICATION DATA

Photo No. _____
Filed At. _____
Object Ident. _____
Ident. By _____
Signature _____

PLANE COORDINATE POSITION DATA

State _____ Zone _____
X _____
Y _____
Estab. By _____
Agency _____

Signature Ken B. B... Title Pls Chief Division _____ Headquarters _____ Date 12/90
FS-7100-52 (3/68)

CORNER RECORD (PERPETUATION)

MONUMENT : DESCRIBE NEW MONUMENT SET, OR WORK DONE TO PRESERVE EXISTING MONUMENT

Remove brush and debris from around corner

ACCESSORIES : DESCRIBE NEW BT'S WITNESS OBJECTS ETC. ESTABLISHED, OR WORK DONE TO PRESERVE EXISTING EVIDENCE

Secured guardpost
Painted red bands around existing BT's

Work Done By GUY (PAT) Streamer Title LAND SURVEYOR Date 12/90 State Registration No. PLS 1341 or Agency

Certified Cor. Record Prepared ? Yes No Filed At: _____ Date _____

REMARKS

WITNESS: KEN BATES

Index File No. Z-7 T. GS R. 32E M. W M Tract or Surv. No. _____ Cor. _____