

CORNER RECORD (SEARCH)
(Ref. FSM 5151.4)

T. 6 S. Merid. Willamette **R. 33 E.**

R.D. **North Fork John Day** County **Umatilla**
N.F. **Umatilla** State **Oregon**

CORNER DIAGRAM



DESCRIBE CORNER MONUMENT FOUND

Found a 2 1/2" aluminum pipe with cap melted off by fire, projecting 5" out of the ground.

DESCRIBE BEARING TREES OR OTHER OFFICIAL ACCESSORIES FOUND

7" Lodgepole Pine Snag, S. 55 W., 12.5 feet, with burnt out blaze.
15" White Fir Snag, N. 58 1/2 W., 14.6 feet, with burnt out blaze.

PHOTO IDENTIFICATION DATA

Photo No.
Filed At.
Object Ident.
Ident. By

Signature

DESCRIBE CORNER LOCATION RELATIVE TO NEAR-BY FEATURES, ALSO HOW TO REACH CORNER

From the junction of roads 52 and 5507 travel southerly on 5507 approximately 1.14 miles to a switchback. From the center of the switchback walk southeasterly up a spur ridge (following the wilderness boundary) approximately 1400 feet to the corner.

PLANE COORDINATE POSITION DATA

State: Zone:

X:

Y:

Datum:

Signature

D. Schlaich

Title

Land Surveyor

Division

Headquarters

S.O.

Date

10/21/1997

CORNER RECORD (PERPETUATION)

MONUMENT: DESCRIBE NEW MONUMENT SET, OR WORK DONE TO PRESERVE EXISTING MONUMENT

Drove 5/8" X 36" rebar, with a 3 1/4" aluminum cap, through the center of the aluminum pipe, 24" in the ground, stamped "NFJD WILDERNESS AP-467 RLS 2308 1997".

ACCESSORIES: DESCRIBE NEW BT'S WITNESS OBJECTS ETC. ESTABLISHED, OR WORK DONE TO PRESERVE EXISTING EVIDENCE

RM, 5/8" X 24" rebar with yellow plastic cap stamped "UMATILLA N.F.", set flush with the ground, N. 54 1/4 E., 17.8 feet.

RM, 5/8" X 24" rebar with red plastic cap stamped "UMATILLA N.F.", set 18" in the ground, S. 47 1/2 E., 15.9 feet.

Work Done By D. Schlaich Title Land Surveyor Date 10/21/1997 State Registration No. _____
or Agency _____
Certified Corner Record Prepared? Yes No _____ Filed At: _____ Date _____

REMARKS

USDA-FOREST SERVICE

Index
File No. _____

CORNER RECORD (SEARCH)

(Ref. FSM 7151.4)

NFSD WILD.
Tract or Survey No. NFSD UNIT Cor. No. 467


T 6S R. 33E

R.D. NORTH FORK JOHN DAY County UMATILLA

Merid. WILLAMETTE

N.F. UMATILLA State OREGON

CORNER DIAGRAM

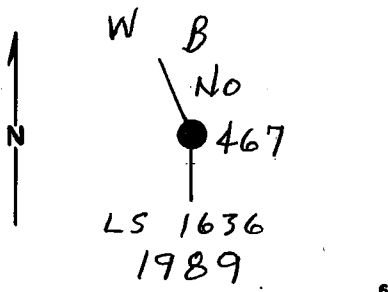

DESCRIBE CORNER MONUMENT FOUND

N/A

DESCRIBE BEARING TREES OR OTHER OFFICIAL ACCESSORIES FOUND

N/A

PHOTO IDENTIFICATION DATA

Photo No. _____
Filed At. _____
Object Ident. _____
Ident. By _____
Signature

DESCRIBE CORNER LOCATION RELATIVE TO NEAR-BY FEATURES, ALSO HOW TO REACH CORNER

PLANE COORDINATE POSITION DATA

State _____ Zone _____
X _____
Y _____
Estab. By _____
Agency

Signature

Title

Division

Headquarters

Date

FS-7100-52 (3/68)

CORNER RECORD (PERPETUATION)

MONUMENT: DESCRIBE NEW MONUMENT SET, OR WORK DONE TO PRESERVE EXISTING MONUMENT

SET 2 1/2" x 30" ALUM. PIPE W/ 3" ALUM. CAP WHICH IS MARKED AS SHOWN IN THE CORNER DIAGRAM.

ACCESSORIES : DESCRIBE NEW BT'S WITNESS OBJECTS ETC. ESTABLISHED, OR WORK DONE TO PRESERVE EXISTING EVIDENCE

8" LODGEPOLE PINE S 55° W, 12.5 FT.
15" W. FIR N 48° W, 14.6 FT. BOTH BLAZED & SCRIBED "WB/467 BT"
& HAVE A 3/4" BRASS WASHER, MARKED "PLS 1636", & HAVE SIGNS
54-3 & 54-9 ATTACHED.

Work Done By D. GAYLORD Title FOREST L.S. Date 6-26-89 State Registration No. 1636
For Agency

Certified Cor. Record Prepared? Yes No Filed At: UMATILLA CO. SURVEYOR Date 1989

REMARKS

Index File No. T. R. M. Tract or Surv. No. Cor. 467