


History of original corner establishment:

The original corner was established by Frank W. Campbell on July 2, 1883, under GLO contract No. 468, as follows:

Set a post for the 1/4 corner, from which:
A 18" tamarack bears S60°W, 10 links (6.6 feet).
A 18" tamarack bears N80°E, 15 links (9.9 feet).

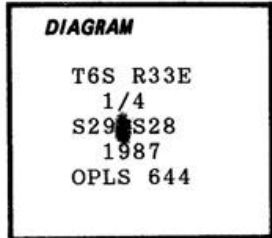

On July 16, 1987, Duane I. Griffith, PLS 644, found a 14" tamarack snag with a healed blaze, bears N80°E, 15 links. A 14" tamarack stump with a healed blaze which he opened to visible scribes, bears S60°W, 10 links. Griffith set a 2 1/2" aluminum pipe with aluminum cap attached, marked as shown in the diagram above, from which:

A 12" spruce bears N53°E, 45.03 feet.
A 5" Lodgepole Pine bears N72°W, 26.36 feet.

Description of corner evidence found:

A 2 1/2" aluminum pipe with a 2 1/2" aluminum cap attached which is marked as shown in the diagram above. The cap is flush with the ground and is surrounded by a mound of stones, from which:

A burnt out root hole bears N88°E, 9.9 feet, all that remains of the original Western Larch bearing tree.

A badly burnt Western Larch stump bears S65°W, 6.6 feet. No marks remain.

A 11" Englemann Spruce snag with burnt out double blazes bears N56°30' E, 44.8 feet.

A burnt Lodgepole Pine stump, no marks remaining, bears N70°W, 26.4 feet.

Description of monument and accessories established to perpetuate the original location of this corner:

New accessories:


A 5/8" x 36" iron rod, set 35" into the ground with a 3/4" brass washer, marked "PLS 1636 S28 NE", attached at ground level, bears N47°30'E, 77.6 feet.

A 5/8" x 36" iron rod, set 35" into the ground with a 3/4" brass washer, marked "PLS 1636 S28 SE", attached at ground level, bears S68°30'E, 94.0 feet.

A 5/8" x 36" iron rod, set 35" into the ground with a 3/4" brass washer, marked "PLS 1636 S29 SW", attached at ground level, bears S48°30'W, 86.1 feet. This iron rod is about 30 feet southerly of a logging road which runs southeast and northwest.

A 5/8" x 36" iron rod, set 35" into the ground with a 3/4" brass washer, marked "PLS 1636 S29 NW", attached at ground level, bears N48°45'W, 91.9 feet.

I hereby certify the above corner point was perpetuated as hereon described on April 16, 1997. Magnetic declination: 20°E.

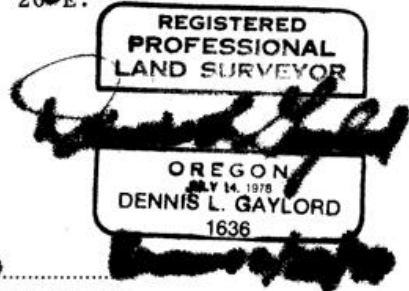

Office of..... County of.....
State of....., I hereby certify that the within instrument was filed in this office for record on the..... day of....., 19.....

(COUNTY OFFICIAL)

RECEIVED BY

Umatilla County Surveyor

Date 4-97

Rec'd by KK

No. 97-75-R