

History of original corner establishment:

Unsurveyed - subdivided section.



No record of subsequent remonumentation found in County Records.

Description of corner evidence found:



None.

Description of monument and accessories established to perpetuate the original location of this corner

Set 2 1/2" x 30" iron pipe 24" in ground with brass cap marked as shown from which I scribed bearing trees:

- A tamarack 16 in. diam. brs. N 05° E 9.00 ft. marked C 1/4 S31 BT
- A tamarack 19 in. diam. brs. S 89° E 32.50 ft. marked C 1/4 S31 BT

Nailed a brass washer marked PLS 933 to the BT blaze of all trees. Set a steel post 4 ft. South of corner. Used T-2 and steel tape, measuring a horizontal distance to the center of the bearing trees.

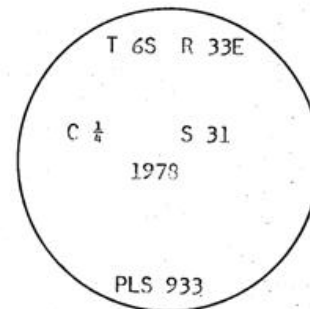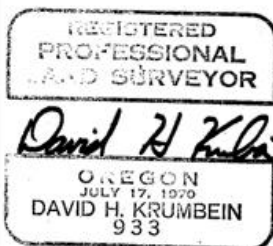

Office of County Surveyor County of Umatilla ..
 State of Oregon .., I hereby certify that the within instrument was filed in this office
 for record on the day of ..
 by
 (COUNTY OFFICIAL) (DEPUTY)