

USDA-FOREST SERVICE

Index
File No. X-4

T 6S R. 33E

Merid. Willamette

CORNER RECORD (SEARCH)

(Ref. FSM 7151.4)

R.D. Ukiah County Umatilla


N.F. Umatilla State Oregon

Tract or
Survey No. X-4

Umatilla

Oregon

CORNER DIAGRAM

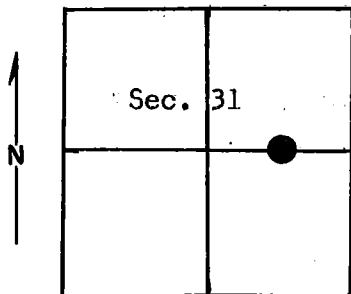

DESCRIBE CORNER MONUMENT FOUND

None

DESCRIBE BEARING TREES OR OTHER OFFICIAL ACCESSORIES FOUND

None

PHOTO IDENTIFICATION DATA

Photo No. _____

Filed At. _____

Object Ident. _____

Ident. By _____

Signature

PLANE COORDINATE POSITION DATA

State _____ Zone _____

X _____

Y _____

Estab. By _____

Agency

Signature

DESCRIBE CORNER LOCATION RELATIVE TO NEAR-BY FEATURES, ALSO HOW TO REACH CORNER

From Texas Bar, take Nye Creek Road S678. Go 3½ miles, turn left on jeep trail 1¼ miles. Walk up the hill 15 chns. to corner.

Beth Ann Murray
Title Division Headquarters

Party Chief

Krumbein Engineering

14 Sep 78
Date

7100-52-(3/68)

CORNER RECORD (PERPETUATION)

MONUMENT: DESCRIBE NEW MONUMENT SET, OR WORK DONE TO PRESERVE EXISTING MONUMENT

Set 2½" x 30" iron pipe with brass cap (stamped)

Pipe is 25" in ground.

T 6S R 33E

E 1/16

C _____ C

S 31

1978

PLS 933

9

ACCESSORIES: DESCRIBE NEW BT'S WITNESS OBJECTS ETC. ESTABLISHED, OR WORK DONE TO PRESERVE EXISTING EVIDENCE

Scribed BT trees.

Pine 14 in. diam. brs. N 07°07' W 24.60 ft. marked CE 1/16 S31 BT with signs 54-3 and 54-4 and brass washer. Pine 14" diam. brs. S 40°45' E 56.10 ft. marked CE 1/16 S31 BT with signs 54-3 and 54-4 and brass washer.

Set steel post 4 ft. South with signs 54-2 and 54-4.

Painted scribed area and red band around trees.

10

Work Done By P. Murphy Title Party Chief Date 8/31/78 State Registration No. _____
or Agency _____

Certified Cor. Record Prepared? Yes No _____ Filed At: Umatilla County Surveyor Date _____ 11

REMARKS

Witness by: R. Barton
M. Murtishaw

Index File No. X-4 T. 6S R. 33E M. Willamette Tract or Surv. No.

Cor.

12

13