

CERTIFIED RECORD OF LAND CORNER MONUMENTATION


X-5

History of original corner establishment:

Corner established in April, 1883, by Frank W. Campbell under Contract No. 468.

40.00 ch. set stone 18" x 10" x 4" 12 inches in ground marked $\frac{1}{8}$ on West face.

A pine 20" diam. brs. S 73° W 26 lks. $\frac{1}{8}$ S BT
A pine 20" diam. brs. S 79° E 11 lks. $\frac{1}{8}$ S BT

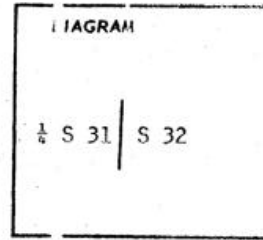

Description of corner evidence found:


Found both bearing trees. Used the call distances from the bearing trees to set corner.

Both trees were good.

Description of monument and accessories established to perpetuate the original location of this corner

Set 2 1/2" x 30" iron pipe 23" in ground with brass cap marked as shown. No new scribed trees.

Set steel post 3 ft. West of corner. The corner is about 600 ft. North of creek.

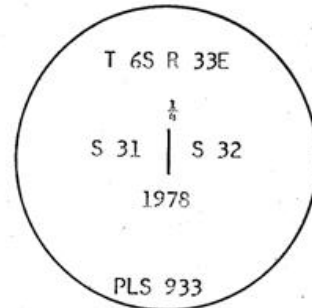

Office of _____ County Surveyor _____ County of Umatilla _____
 State of Oregon _____, I hereby certify that the within instrument was filed in this office
 for record on the _____ day of _____
 _____ by _____
 (COUNTY OFFICIAL) (DEPUTY)

Q-915