


CERTIFIED RECORD OF LAND CORNER MONUMENTATION

7-3

History of original corner establishment:

Unsurveyed - subdivided section

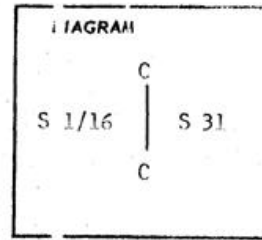

No record of subsequent remonumentation found in County Records.

Description of corner evidence found:


None.

Description of monument and accessories established to perpetuate the original location of this corner

Set 2 1/2" x 30" iron pipe 25" in ground with brass cap marked as shown from which I scribed bearing trees:

- A fir 11 in. diam. brs. N 08°56' W 10.1 feet marked S 1/16 C S31 BT
- A tamarack 16 in. diam. brs. N 87°38' W 61.5 ft. marked S 1/16 C S31 BT

Nailed a brass washer marked PLS 933 to the BT blaze of both trees. Set a steel post 3 ft. East of corner. The corner is East 12 ft. from road which runs NW by SE. Used T-2 and steel tape, measuring the horizontal distance to the center of the bearing trees.

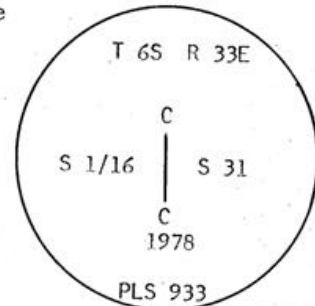

Office of ..... County Surveyor ..... County of ..... Umatilla .....  
 State of ..... Oregon ..... , I hereby certify that the within instrument was filed in this office  
 for record on the ..... day of .....  
 ..... by .....  
 (COUNTY OFFICIAL) (DEPUTY)

Q-912