


CERTIFIED RECORD OF LAND CORNER MONUMENTATION

History of original corner establishment:

Unsurveyed - subdivided section

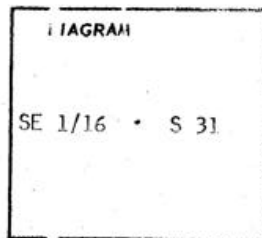

No record of subsequent remonumentation found in County Records.

Description of corner evidence found:

None

Description of monument and accessories established to perpetuate the original location of this corner

Set 2½" x 30" iron pipe 21" in ground with brass cap marked as shown from which I scribed bearing trees:


- A fir 12 in. diam. brs. S 15° 49' W 32.75 ft. marked SE 1/16 S31 BT
- A fir 13 in. diam. brs. N 84° 32' E 15.20 ft. marked SE 1/16 S31 BT

Nailed a brass washer marked PLS 933 to the BT blaze of all trees. Raised mound of stone to top of brass cap. Set a steel post 4 ft. North of corner. Corner is SE 200 ft. from road which runs NE by SW. Used T-2 and steel tape, measuring a horizontal distance to the center of bearing trees.

REGISTERED PROFESSIONAL LAND SURVEYOR

David H. Krumba

OREGON JULY 17, 1919 DAVID H. KRUMBEIN 933

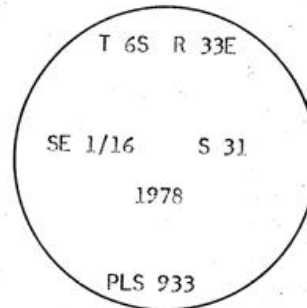

Office of County Surveyor County of Umatilla

State of Oregon, I hereby certify that the within instrument was filed in this office for record on the day of

(COUNTY OFFICIAL) by (DEPUTY)

Q-914

y-4