

Index
File No. Z-23

CORNER RECORD (SEARCH)

(Ref. FSM 7151.4)

Tract or
Survey No. _____
Cor.
No. _____


T 65 R. 33E

R.D. NORTH FORK JOHN DAY County UMATILLA / GRANT COUNTY LINE

Merid. WILL

N.F. UMATILLA State OREGON

CORNER DIAGRAM

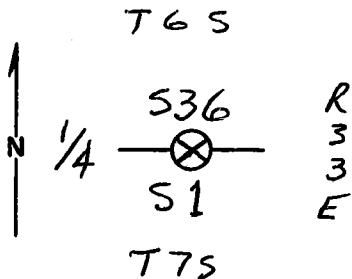

DESCRIBE CORNER MONUMENT FOUND

CORNER TREE IS A 20" WESTERN LARCH SNAG WITH A LARGE HEALED BLAZE ON NORTH SIDE, A SMALLER HEALED BLAZE ON SOUTH SIDE & DOUBLE HEALED HACKS, SIMILAR TO LINE TREE HACKS, ON BOTH EAST & WEST SIDES.

DESCRIBE BEARING TREES OR OTHER OFFICIAL ACCESSORIES FOUND

ORIG. 15" SPRUCE IS DEAD & DOWN. HAS A ROTTED & BURNT OUT SINGLE BLAZE. NO MARKS REMAIN. ROOT CROWN BEARS 545°E, 2°feet.

PHOTO IDENTIFICATION DATA

Photo No. _____
Filed At. _____
Object Ident. _____
Ident. By _____
Signature _____

ORIG. 26" LARCH IS GONE. PLACED BT SIGNS ON BOTH TREES & A LOCATION POSTER ON A

PLANE COORDINATE POSITION DATA

State _____ Zone _____
X _____
Y _____
Estab. By _____
Agency _____

DESCRIBE CORNER LOCATION RELATIVE TO NEAR-BY FEATURES, ALSO HOW TO REACH CORNER
24" FIR N15°E, 38 feet FROM CORNER. A 50 FOOT HIGH ROCK OUTCROP BEARS 545°W, 75 FEET. PUT LOCATION POSTER ON A 14" FIR ON RIDGE TOP/ WILDERNESS BOUNDARY 970 feet FROM CORNER TO THE WEST. THIS POSTER IS 225 FT NORTH OF (SEE BACK)

Signature Dennis L. Hayford Title _____ Division PLS 1636 Headquarters SO Date 9-13-89 FS-7100-52 (3/68)

CORNER RECORD (PERPETUATION)

MONUMENT: DESCRIBE NEW MONUMENT SET, OR WORK DONE TO PRESERVE EXISTING MONUMENT

9

ACCESSORIES : DESCRIBE NEW BT'S WITNESS OBJECTS ETC. ESTABLISHED, OR WORK DONE TO PRESERVE EXISTING EVIDENCE

10

Work Done By _____ Title _____ Date _____ State Registration No. or Agency _____

Certified Cor. Record Prepared? Yes No Filed At: _____ Date _____

11

REMARKS

WILDERNESS BOUNDARY MONUMENT No. 432.

12

Index File No. T. R. M. Tract or Surv. No. Cor. _____

13