


History of original corner establishment:

Corner originally established by Frank W. Campbell in July, 1883, under contract No. 468, as follows:

Set a basalt stone, 12"x 10x 10", from which:

- A 12" Tamarack bears N25° E, 137 links (90.42 feet).
- A 18" Tamarack bears S43° E, 135 links (89.10 feet).
- A 4" Pine bears S18° W, 73 links (48.18 feet).
- A 11" Tamarack bears N19° W, 136 links (89.76 feet).

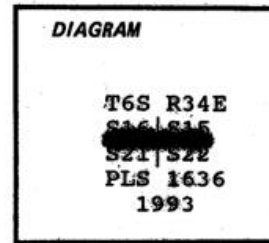

Description of corner evidence found:

The original corner stone is gone.  
 A 22" Western Larch with scribes visible on a charred and nearly healed blaze bears N26° 45' E, 90.42 feet.  
 A 20" Western Larch with scribes visible on a charred blaze bears N19° 45' W, 89.76 feet.

Description of monument and accessories established to perpetuate the original location of this corner:

At the intersection of record distances from the remaining bearing trees, set a 2 1/2" by 30" aluminum pipe 30" into the ground with a mound of stones around the pipe. A 3 1/4" aluminum cap attached is marked as shown in the diagram above. From which:

- A 15" White Fir scribed "T6S R34E S21 BT" bears S30° W, 29.8 feet.
- A 15" Western Larch scribed "T6S R34E S22 BT" bears S56° E, 77.1 feet.


Both new bearing trees are scribed on double blazes and have a 3/4" brass washer, marked "PLS 1636", nailed flush to the lower blaze. All 4 bearing trees have a 54-3; Bearing Tree sign nailed above the blazes and a 54-9, Land Survey Monument sign nailed to the back.

I hereby certify the above corner point was perpetuated as hereon described on September 1, 1993.

Magnetic Declination: 22° E.

NAD1983 Geographic Position (+ or - 2 to 6 meters):  
 Latitude 45-02-27.059 N  
 Longitude 118-36-59.029 W

Witnessed by: Troy Allen

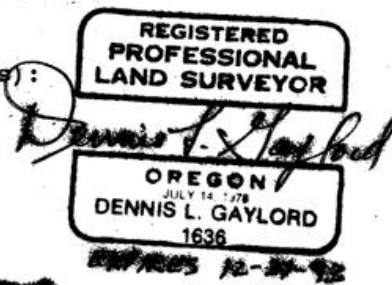

Office of..... County of.....  
 State of....., I hereby certify that the within instrument was filed in this office for record on the..... day of....., 19.....  
 ..... by .....  
 (COUNTY OFFICIAL) (DEPUTY)

Form R6-7100-57 (9/71)

**RECEIVED BY**  
 Umatilla County Surveyor  
 Date 10-93  
 Rec'd By KR  
 No. 93-75-R

N-13