

Index
File No.

T. 6 S. R. 34 E.
Merid. Willamette

CORNER RECORD (SEARCH)
(Ref. FSM 5151.4)

R.D. North Fork John Day
N.F. Umatilla

County Umatilla
State Oregon

Tract or
Survey No.

Tower Unit

Cor.
No. AP-550

CORNER DIAGRAM



PHOTO IDENTIFICATION DATA

Photo No.
Filed At.
Object Ident.
Ident. By
Signature

PLANE COORDINATE POSITION DATA

State: Zone:
X:
Y:
Datum:

DESCRIBE CORNER MONUMENT FOUND

Found a 5/8" rebar with the 2 1/2" core of a melted aluminum cap, projecting 3" out of the ground.

DESCRIBE BEARING TREES OR OTHER OFFICIAL ACCESSORIES FOUND

- 6" Lodgepole Pine Snag, N. 49 E., 27.9 feet, with scribing visible on burnt double blaze.
- 8" Lodgepole Pine Snag, S. 57 E., 27.0 feet, with burnt out double blaze.
- 9" Lodgepole Pine, N. 60 1/2 W., 70.3 feet, with scribing visible on double blaze.
- 12" Lodgepole Pine, N. 40 1/2 W., 113.2 feet, with scribing visible on double blaze.
- 8" Lodgepole Pine, N. 9 W., 130.8 feet, with scribing visible on double blaze.

DESCRIBE CORNER LOCATION RELATIVE TO NEAR-BY FEATURES, ALSO HOW TO REACH CORNER

Signature
D. Schlaich

Title
Land Surveyor

Division

Headquarters
S.O.

Date
09/1997

CORNER RECORD (PERPETUATION)

MONUMENT: DESCRIBE NEW MONUMENT SET, OR WORK DONE TO PRESERVE EXISTING MONUMENT

ACCESSORIES: DESCRIBE NEW BT'S WITNESS OBJECTS ETC. ESTABLISHED, OR WORK DONE TO PRESERVE EXISTING EVIDENCE

Work Done By D. Schlaich Title Land Surveyor Date 09/1997 State Registration No. or Agency _____
Certified Corner Record Prepared? Yes No Filed At: _____ Date: _____

REMARKS

Index File No.

T. **6 S.**

R. **34 E.**

M. **Willamette**

Tract or Survey No. **Tower Unit**

Cor. **AP-550**

USDA-FOREST SERVICE
Index
File No.

T. 6 S. R. 34 E.
Merid. Willamette

CORNER RECORD (SEARCH)
(Ref. FSM 6151.4)

R.D. North Fork John Day
N.F. Umatilla

County Umatilla
State Oregon

Tract or
Survey No. Tower Unit

Cor.
No. AP-550

CORNER DIAGRAM



DESCRIBE CORNER MONUMENT FOUND

The aluminum cap is protruding 3" above the surface of the ground and is partly melted by the heat from a forest fire, but is still legible.

DESCRIBE BEARING TREES OR OTHER OFFICIAL ACCESSORIES FOUND

6" Lodgepole Pine Snag, with visible scribes, N. 49 E., 27.9 feet.
8" Lodgepole Pine Snag, with burnt out double blaze, S. 57 E., 27.0 feet.

PHOTO IDENTIFICATION DATA

Photo No.
Filed At.
Object Ident.
Ident. By

Signature

DESCRIBE CORNER LOCATION RELATIVE TO NEAR-BY FEATURES, ALSO HOW TO REACH CORNER

The corner is located at a point 200 feet northwesterly of the centerline of trail 3156 (Big creek) and 200 feet northerly of and perpendicular to the centerline of road 52.

PLANE COORDINATE POSITION DATA

State: Zone:
X:
Y:
Datum:

Signature

D. Gaylord

Title

Land Surveyor

Division

Headquarters

S.O.

Date

05/08/1997

FS-7100-52 (3/97)

CORNER RECORD (PERPETUATION)

MONUMENT: DESCRIBE NEW MONUMENT SET, OR WORK DONE TO PRESERVE EXISTING MONUMENT

ACCESSORIES: DESCRIBE NEW BT'S WITNESS OBJECTS ETC. ESTABLISHED, OR WORK DONE TO PRESERVE EXISTING EVIDENCE

9" Lodgepole Pine, N. 60 1/2 W., 70.3 feet, scribed "WB/550" "BT" on double blaze.

12" Lodgepole Pine, N. 40 1/2 W., 113.2 feet, scribed "WB/550" "BT" on double blaze.

8" Lodgepole Pine, N. 9 W., 130.8 feet, scribed "WB/550" "BT" on double blaze.

Work Done By D. Gaylord Title Land Surveyor Date 05/08/1997 State Registration No. or Agency _____

Certified Corner Record Prepared? Yes No Filed At: _____ Date _____

REMARKS

Index

File No.

T. 6 S.

R. 34 E.

Merid. WILLAMETTE

CORNER RECORD (SEARCH)

(Ref. FSM 7151.4)

Tract or

Survey No. Tower Unit

Cor.

No. AP-550


R.D. NFJD

County UMATILLA

N.F. UMATILLA

State OREGON

CORNER DIAGRAM

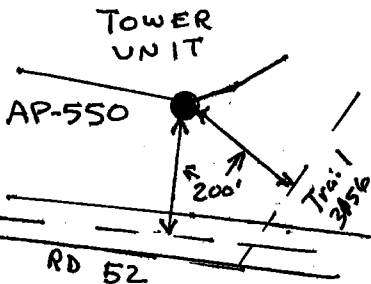

DESCRIBE CORNER MONUMENT FOUND

NONE

DESCRIBE BEARING TREES OR OTHER OFFICIAL ACCESSORIES FOUND

NONE

PHOTO IDENTIFICATION DATA

Photo No.:

Filed At.:

Object Ident.:

Ident. By:

Signature

DESCRIBE CORNER RELATIVE TO NEAR-BY FEATURES, ALSO HOW TO REACH CORNER

The corner is located at point 200 feet northwesterly of the centerline of Forest trail ³¹⁵⁶ ~~3050~~ and 200 feet northerly of the centerline of road 52.

PLANE COORDINATE POSITION DATA

State: Oregon Zone: North

X: 2,487,814.51'

Y: 496,090.27'

Datum: NAD1927

Signature

D. Schlaich

Title

Land Surveyor

Division

Headquarters

S.O.

Date

06-1993

FS-7100-52 (3/68)

CORNER RECORD (PERPETUATION)

MONUMENT: DESCRIBE NEW MONUMENT SET, OR WORK DONE TO PRESERVE EXISTING MONUMENT

5/8" by 3/8" rebar, with a 3 1/4" aluminum cap, 35" in the ground, marked "NFJD WILDERNESS TOWER UNIT AP-550 RLS2308 1993".

ACCESSORIES : DESCRIBE NEW BT's WITNESS OBJECTS ETC. ESTABLISHED, OR WORK DONE TO PRESERVE EXISTING EVIDENCE

6" Lodgepole Pine, N. 49° E., 27.9 ft., mkd. "WB/550""BT" on double blaze.

7" Lodgepole Pine, S. 57° E., 27.1 ft., mkd. "WB/550"BT" on double blaze.

Work Done By **D. Schlaich**

Title Land Surveyor

Date **06-1993**

State Registration No.
or Agency

Certified Cor. Record Prepared ? **NO**

Filed At:

Date

REMARKS

Index File No.

T.

6 S.

R.

34 E.

M.

W.M.

Tract or Survey No.

Tower Unit

Cor.

AP-550