

USDA-FOREST SERVICE

Index
File No. T-25
T 65 R. 34E
Merid. # Will


CORNER RECORD (SEARCH)

UKIAH (Ref. FSM 7151.4)

Tract or
Survey No. _____ Cor.
No. _____

R.D. ~~Ukiah~~ Umatilla County Umatilla
N.F. Umatilla State Oregon

CORNER DIAGRAM

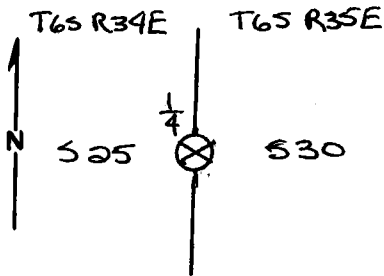

DESCRIBE CORNER MONUMENT FOUND

No evidence found. Orig. 12" LP pine corner tree is gone.

DESCRIBE BEARING TREES OR OTHER OFFICIAL ACCESSORIES FOUND

Orig. 8" dia. LP pine is now 12" and is alive with ~~upper~~ ^{blaze} has been previously opened and scribing "1/4 S" is visible. ~~Small lower~~ ^{tree bears} ~~blaze~~ is healed. Tree bears N86°W, 7 ft from corner.

Orig. 10" dia LP pine is alive and still about 10" dia. with single blaze that has been previously opened and scribing "1/4" is visible. Tree bears S69°E, 14 ft from corner.

DESCRIBE CORNER LOCATION RELATIVE TO NEAR-BY FEATURES, ALSO HOW TO REACH CORNER

BT tags had been put up by M.L.C. on 9/20/72.

Location poster put up on north side of road 5226. Corner is north 130 yds from poster.

PHOTO IDENTIFICATION DATA

Photo No. _____
Filed At. _____
Object Ident. _____
Ident. By _____
Signature

PLANE COORDINATE POSITION DATA

State _____ Zone _____
X _____
Y _____
Estob. By _____
Agency

Signature Cathy M. McGuire *Title* Volunteer *Division* _____ *Headquarters* 50 *Date* 8/7/84 7100-52-(3,68)

CORNER RECORD (PERPETUATION)

MONUMENT : DESCRIBE NEW MONUMENT SET, OR WORK DONE TO PRESERVE EXISTING MONUMENT

9

ACCESSORIES : DESCRIBE NEW BT'S WITNESS OBJECTS ETC. ESTABLISHED, OR WORK DONE TO PRESERVE EXISTING EVIDENCE

10

Work Done By _____ Title _____ Date _____ State Registration No. or Agency _____

Certified Cor. Record Prepared ? Yes No Filed At: _____ Date _____

11

REMARKS

12

Index File No. T. R. M. Tract or Surv. No. Cor.

13