

USDA-FOREST SERVICE

Index

File No. V-25

CORNER RECORD (SEARCH)

(Ref. FSM 7151.4)

Tract or Survey No. _____ Cor. No. NE


T 6 S R. 34 E

R.D. NORTH FORK JOHN DAY County Umatilla

Merid. Willamette

N.F. Umatilla State OREGON

CORNER DIAGRAM

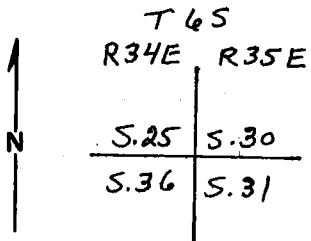

DESCRIBE CORNER MONUMENT FOUND

Stone 18"X12"X3" (20"X13"X5") w/7 fragments, pieced together I find 5 notches on North and 1 notch on South face.

DESCRIBE BEARING TREES OR OTHER OFFICIAL ACCESSORIES FOUND

- ① No trace of N.E. B.T.
- ② 16" D.B.H. (12") Tamarack, S. 52°E, 139 LKS., w/opened face, no marks. Blaze below, grown shut.
- ③ S.W. B.T. only charred wood remains.
- ④ N.W. B.T., Rotten Remains of stump, N. 70°W., 4 LKS.

PHOTO IDENTIFICATION DATA

Photo No. _____

Filed At. _____

Object Ident. _____

Ident. By _____

Signature

DESCRIBE CORNER LOCATION RELATIVE TO NEAR-BY FEATURES, ALSO HOW TO REACH CORNER

Take Road 5226 To Tag on left, go south to corner.

PLANE COORDINATE POSITION DATA

State _____ Zone _____

X _____

Y _____

Estab. By _____

Agency

Signature _____ Title _____ Division _____ Headquarters _____ Date 10/24/86

Signature Land Surveyor

CORNER RECORD (PERPETUATION)

MONUMENT: DESCRIBE NEW MONUMENT SET, OR WORK DONE TO PRESERVE EXISTING MONUMENT

Set a $2\frac{1}{2}$ " Diam. Alum. Cap on a $2\frac{1}{2}$ " X 30" Alum. Pipe w/f/ared bottom at corners and buried cornerstone and fragments along pipe. Cap MKD. Per sketch. Set steel posts 4"± N. & S. w/Attn. & Mon. signs attached.

T 6 S	
R 34 E	R 35 E
5.25	5.30
5.34	5.31
RPLS 1910 1986	

9

ACCESSORIES: DESCRIBE NEW BT'S WITNESS OBJECTS ETC. ESTABLISHED, OR WORK DONE TO PRESERVE EXISTING EVIDENCE

- ① 5" DBH. White Fir, N. 61° E, 21.3', scribed "X" BT.
- ② 15" DBH. TAMARACK, N. 81° W., 36.5', scribed T 6 S R 34 E S 25 BT.
- ③ 20" DBH. Douglas Fir, S. 14 1/2° W., 31.7', scribed T 6 S R 34 E S 36 BT
- ④ 16" DBH Douglas Fir, S. 51 1/2° E, 76.6' scribed T 6 S R 35 E S 31 BT.

Each B.T. has a brass washer mkd. RPLS 1910 set btwn. B. & T. All B.T's. have B.T. Tags, Attn. signs, Bands & Faces painted red.

10

Work Done By C.J. Martin Title Land Surveyor Date 10/25/86 State Registration No. LS 1910
or Agency

Certified Cor. Record Prepared? Yes No Filed At: _____ Date _____

11

REMARKS

12

Index File No. V-25 T. 6 S R. 34 E M. Willamette Tract or Surv. No. 36 Cor. 25/30
36/31

13

USDA-FOREST SERVICE

Index File No. V-25

CORNER RECORD (SEARCH)

(Ref. FSM 7151.4)

Tract or Survey No. _____

Cor. No. _____

T 65 R. 34E

R.D. DALE

County ~~GAMMA~~ UMATILLA


Merid. Will

N.F. UMATILLA

State OREGON

CORNER DIAGRAM

T65

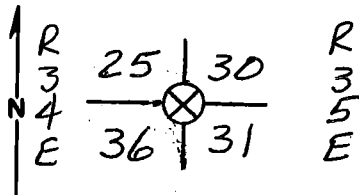

DESCRIBE CORNER MONUMENT FOUND

ORIG. CORNER STONE IS SOLIDLY SET IN AN UPRIGHT POSITION. TOP IS BROKEN. I PIECE THE STONE TOGETHER & FIND 5 GROOVES ON THE NORTH FACE & ONE GROOVE ON THE SOUTH FACE.

DESCRIBE BEARING TREES OR OTHER OFFICIAL ACCESSORIES FOUND

ORIG. 18" FIR IS DOWN & DECAYED. I FIND AXE MARKS & CHARRED FACE. STUMP BEARS N70°W, 2 1/2 FT. A CHARRED & DECAYED LOG IS IN POSITION OF ORIG. S.W. B.T. NO MARKS VISIBLE. I OPEN A TAMARACK AT APPROX. LOCATION OF ORIG. SE BT, BUT FIND NO MARKS. ORIG. DISTANCE HARD TO

PHOTO IDENTIFICATION DATA

Photo No. _____

Filed At. _____

Object Ident. _____

Ident. By _____

Signature

PLANE COORDINATE POSITION DATA

State _____ Zone _____

X _____

Y _____

Estab. By _____

Agency

DESCRIBE CORNER LOCATION RELATIVE TO NEAR-BY FEATURES, ALSO HOW TO REACH CORNER

READ IN ORIG. NOTES. THERE ARE SEVERAL TREES IN IMMEDIATE VICINITY OF CORNER WHICH ARE BLAZED FACING THE CORNER.

Signature

Title

Division

Headquarters

Date

Dennis T. Layford

PLS 1636

SO

8/30/84

7100-52-(3.68)

CORNER RECORD (PERPETUATION)

MONUMENT: DESCRIBE NEW MONUMENT SET, OR WORK DONE TO PRESERVE EXISTING MONUMENT

ACCESSORIES : DESCRIBE NEW BT's WITNESS OBJECTS ETC. ESTABLISHED, OR WORK DONE TO PRESERVE EXISTING EVIDENCE

Work Done By _____ **Title** _____ **Date** _____ **State Registration No. or Agency** _____

Certified Cor. Record Prepared ? Yes No **Filed At:** _____ **Date** _____

REMARKS

Index File No. **T.** **R.** **M.** **Tract or Surv. No.** **Cor.**